

LAND CORNER RECORDATION CERTIFICATE
Filing Requirement of Act 74, Mich. P.A. 1970

RECORDED

1999 NOV 30 PM 3:23

For corners in

DICKINSON
 (County)
 SAGOLA TOWNSHIP
 BREITUNG TOWNSHIP

Located In: Corner

1. Public Land Survey T 41 N R 30 W B-7
T 41 N R 30 W C-10
 T ___ R ___
 T ___ R ___
 2. Property Controlling Section S ___ T ___ R ___ SURVEY &
 S ___ T ___ R ___ REMONUMENTATION
 3. Miscellaneous Property in Sec. S ___ T ___ R ___
 S ___ T ___ R ___ MAR 24 2000

REGISTER OF DEEDS
 DICKINSON COUNTY
 MICHIGAN

Register of Deeds Stamp & File Number

4. Lot No. _____, Recorded Plat _____ SECTION _____

5. Private Claims _____

I, JAMES H. MOORE, in a field survey on AUGUST 18, 1999 do hereby state that under requirements of P.A. 74, Michigan P.A. of 1970, the corner points mentioned in lines 1 and 2 above were in conformance with regulations and rules therefore as required in the current manual of survey instructions of the United States Department of the Interior, Bureau of Land Management or by a decree of a Court of Law and /or that the corner points mentioned in lines 3, 4 and 5 above were in conformance with the rules of the Michigan Board of Land Surveyors or by a Decree of a Court of Law; established, re-established, monumented, recovered, found as expressed below:

	A	B	C	D	E	F	G	H	I	J	K	L	M
1													
2		6		5		4		3		2		1	
3													
4		7		8		9		10		11		12	
5													
6		18		17		16		15		14		13	
7		●											
8		19		20		21		22		23		24	
9													
10		30		29		28		27		26		25	
11													
12		31		32		33		34		35		36	
13													

NOTE: Not more than 2 corners, all in the same town and range, may be recorded on this certificate.

A. Description of original monument and accessories and/or subsequent restoration:

- B-7 ¼ CORNER COMMON TO SECTIONS 18 AND 19. POST BY JOHN BURT, D.S. 1849
 ASPEN 12" EAST 9.59 CHAINS
 ASPEN 12" WEST 10.12 CHAINS
- C-10 ¼ CORNER COMMON TO SECTIONS 29 AND 30.
 POST BY JOHN BURT, D.S. 1849
 ASPEN 9" N 85° W 5 LINKS
 ASPEN 9" S 26° E 24 LINKS


B. Description of corner evidence found and/or method applied in restoring or reestablishing corner:

- B-7 FOUND 1-1/2" PIPE AT GROUND LEVEL WITH A 3" X 3" SQUARE POST. PER ROBERT SPEAR REMONUMENTATION REPORT DATED 12-7-98.
- C-10 FOUND 5/8" REBAR AND CAP APPROXIMATELY 0.10' BELOW GRAVEL ROAD, RLS 15408. PER ROBERT SPEAR REMONUMENTATION REPORT DATED 12-7-98.

C. Description of monument for corner and accessories established to perpetuate locating the position of the corner:

- B-7 SET DICKINSON COUNTY 4" ALUMINUM CAP INSIDE EXISTING MONUMENT. NEW WITNESSES.
 BLACK SPRUCE 7" S 05° W (M.B.) 20.25' NAIL/TAG
 CEDAR 12" N 44° W (M.B.) 8.77' NAIL/TAG
 BALSAM 6" N 01° E (M.B.) 18.25' NAIL/TAG
 BLACK SPRUCE 6" S 40° E (M.B.) 16.15' NAIL/TAG
 CARSONITE MARKER N 76° E 1.00'
- C-10 SET DICKINSON COUNTY MONUMENT WITH 4" ALUMINUM CAP. NEW WITNESSES.
 EXISTING B.T. 16" WHITE BIRCH S 66° W (M.B.) 64.09' NAIL/TAG
 MAPLE 8" N 14° E (M.B.) 52.76' NAIL/TAG
 SPRUCE 4" N 65° E (M.B.) 40.40' NAIL/TAG
 BALSAM 5" N 76° W (M.B.) 56.91' NAIL/TAG
 CARSONITE MARKER WEST 20.50'
 REFERENCE MONUMENT WEST 20.00'

Signed by JAMES H. MOORE Date 11-8-99
 Surveyor's Michigan License No. 28423

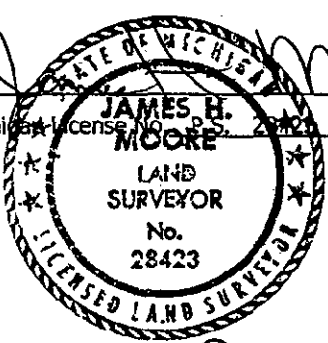

FORM APPROVED BY MICHIGAN STATE BOARD OF PROFESSIONAL SURVEYORS, JAN. 28, 1971

ACCEPTED BY THE DICKINSON COUNTY SURVEY PEER GROUP AS THE OFFICIAL CORNER UNDER MICHIGAN PUBLIC ACT 345 OF 1990 AT A MEETING HELD ON 11-23-99

REVISED MAY 14, 1975
 REVISED JAN., 1983
 REVISED OCT., 1995

LIBER 3 PAGE 15

COUNTY REPRESENTATIVE