

F-1/F-13 T42N-R30W  
E-1/E-13 T42N-R30W

**LAND CORNER RECORDATION CERTIFICATE**  
Filing Requirement of Act 74, Mich. P.A. 1970

RECORDED

1999 NOV 30 PM 3:24

For corners in

DICKINSON Located In: Corner Code #  
(County)

SAGOLA TOWNSHIP

1. Public Land Survey T 41 N R 30 W F-1  
T 41 N R 30 W E-1  
T R  
T R  
2. Property Controlling S T R SURVEY &  
in Section S T R RE-MONUMENTATION  
3. Miscellaneous S T R  
Property in Sec. S T R

REGISTER OF DEEDS  
DICKINSON COUNTY  
RECORDS

Register of Deeds Stamp & File Number

4. Lot No. \_\_\_\_\_, Recorded Plat \_\_\_\_\_  
SECTION

5. Private Claims \_\_\_\_\_

I, JAMES H. MOORE, in a field survey on NOVEMBER 4, 19 99 do hereby state that under requirements of P.A. 74, Michigan P.A. of 1970, the corner points mentioned in lines 1 and 2 above were in conformance with regulations and rules therefore as required in the current manual of survey instructions of the United States Department of the Interior, Bureau of Land Management or by a decree of a Court of Law and /or that the corner points mentioned in lines 3, 4 and 5 above were in conformance with the rules of the Michigan Board of Land Surveyors or by a Decree of a Court of Law; established, re-established, monumented, recovered, found as expressed below:

	A	B	C	D	E	F	G	H	I	J	K	L	M
1													
2	6			5		4		3		2		1	
3													
4	7			8		9		10		11		12	
5													
6	18			17		16		15		14		13	
7													
8	19			20		21		22		23		24	
9													
10	30			29		28		27		26		25	
11													
12	31			32		33		34		35		36	
13													

**NOTE: Not more than 2 corners, all in the same town and range, may be recorded on this certificate.**

A. Description of original monument and accessories and/or subsequent restoration:

E-1 1/4 CORNER COMMON TO SECTION 4, T41N-R30W AND SECTION 33, T42N-R30W  
HEMLOCK POST BY WILLIAM A. BURT, D.S. 1846  
HEMLOCK 8" N 79°E 24 LINKS  
HEMLOCK 5" N 33°W 3 LINKS

E-1 CORNER COMMON TO SECTIONS 4-5, T41N-R30W AND SECTIONS 32-33, T42N-R30W  
CEDAR POST BY WILLIAM A. BURT, D.S. 1846  
CEDAR 6" N30°E 6 LINKS  
TAMARACK 8" N86°W 23 LINKS

FOUND 1930 DCRC MAP INDICATES A 1 1/2" PIPE WAS AT THE CORNER POSITION. FOUND PIPE IS 117.79 SOUTH AND 37.97 FEET EAST OF SINGLE PROPORTIONATE POSITION DCRC TIE TO CENTER OF SECTION WAS 2748.90 DID NOT ACCEPT 1 1/2" PIPE.

ACCEPTED BY THE DICKINSON COUNTY SURVEY PEER GROUP AS THE OFFICIAL CORNER UNDER MICHIGAN PUBLIC ACT 345 OF 1990 AT A MEETING HELD ON 11-23-99

B. Description of corner evidence found and/or method applied in restoring or reestablishing corner: COUNTY REPRESENTATIVE

E-1 FOUND NOTHING AT SINGLE PROPORTIONATE POSITION, SET CORNER ON LINE BETWEEN SECTION CORNERS AT A SINGLE PROPORTIONATE DISTANCE.

E-1 FOUND 1 1/4" PIPE NEXT TO CEDAR POST SET BY PERSONS UNKNOWN. THIS PIPE AGREED WITH SECTION CORNERS EAST AND WEST, I ACCEPTED THIS MONUMENT AS THE BEST AVAILABLE EVIDENCE FOR THE CORNER POSITION


C. Description of monument for corner and accessories established to perpetuate locating the position of the corner:

E-1 SET DICKINSON COUNTY MONUMENT WITH 4" ALUMINUM CAP. NEW WITNESSES  
7" BLACK SPRUCE N 28° E (M.B.) 37.31' NAIL/TAG  
10" BLACK SPRUCE S 72° E (M.B.) 13.85' NAIL/TAG  
6" BLACK SPRUCE N 42° W (M.B.) 15.25' NAIL/TAG  
5" BLACK SPRUCE S 61° W (M.B.) 22.50' NAIL/TAG  
CARSONITE MARKER WEST 1.0'

E-1 SET DICKINSON COUNTY MONUMENT INSIDE EXISTING PIPE WITH 4" ALUMINUM CAP. NEW WITNESSES  
FOUND 5" CEDAR N52°W (M.B.) 19.02' NAIL/TAG  
7" CEDAR N05°E (M.B.) 26.38' NAIL/TAG  
6" CEDAR S02°E (M.B.) 8.89' NAIL/TAG  
5" BLACK ASH N82°E (M.B.) 26.63' NAIL/TAG  
CARSONITE MARKER WEST 1.0'

Signed by JAMES H. MOORE  
Surveyor's Michigan License No. 28423

Date 11-8-99

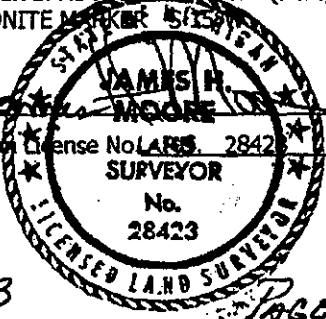

ACCEPTED BY THE DICKINSON COUNTY SURVEY PEER GROUP AS THE OFFICIAL CORNER UNDER MICHIGAN PUBLIC ACT 345 OF 1990 AT A MEETING HELD ON 11-23-99

RB Parker  
COUNTY REPRESENTATIVE

REVISED MAY 14, 1975  
REVISED JAN., 1983  
REVISED OCT., 1995

Liber B

PAGE 17