

LAND CORNER RECORDATION CERTIFICATE
Filing Requirement of Act 74, Mich. P.A. 1970

RECORDED

1999 NOV 30 PM 3:23

For corners in

DICKINSON Located In: _____ Corner Code # _____
 (County)
 BREITUNG TOWNSHIP
 1. Public Land Survey T 41 N R 30 W E-10
 T 41 N R 30 W E-11
 T _____ R _____
 T _____ R _____
 2. Property Controlling S _____ T _____ R _____
 in Section S _____ T _____ R _____
 3. Miscellaneous S _____ T _____ R _____
 Property in Sec. S _____ T _____ R _____

REGISTERED DEEDS
 GIVEN

Register of Deeds Stamp & File
 Number

MAR 24 2000

4. Lot No. _____, Recorded Plat _____

5. Private Claims _____ SECTION _____

I, JAMES H. MOORE, in a field survey on AUGUST 17, 19 99 do hereby state that under requirements of P.A. 74, Michigan P.A. of 1970, the corner points mentioned in lines 1 and 2 above were in conformance with regulations and rules therefore as required in the current manual of survey instructions of the United States Department of the Interior, Bureau of Land Management or by a decree of a Court of Law and /or that the corner points mentioned in lines 3, 4 and 5 above were in conformance with the rules of the Michigan Board of Land Surveyors or by a Decree of a Court of Law; established, reestablished, monumented, recovered, found as expressed below:

	A	B	C	D	E	F	G	H	I	J	K	L	M
1													
2	6		5		4		3		2		1		
3													
4	7		8		9		10		11		12		
5													
6	18		17		16		15		14		13		
7													
8	19		20		21		22		23		24		
9													
10	30		29		28		27		26		25		
11													
12	31		32		33		34		35		36		
13													

NOTE: Not more than 2 corners, all in the same town and range, may be recorded on this certificate.

A. Description of original monument and accessories and/or subsequent restoration:

<u>E-10</u> 1/4 CORNER COMMON TO SECTIONS 28-29 SPRUCE POST BY JOHN BURT, D.S. 1849 TAMARACK 10" N 17°E 136 LINKS WHITE PINE 12" S 20°W 42 LINKS	<u>E-11</u> CORNER COMMON TO SECTIONS 28-29-32-33 CEDAR POST BY JOHN BURT, D.S. 1849 CEDAR 12" S55°E 32 LINKS ASPEN 5" N58°W 15 LINKS
---	--

B. Description of corner evidence found and/or method applied in restoring or reestablishing corner:


<u>E-10</u> FOUND 1-1/2" PIPE WITH 2 EXISTING B.T.'S PER ROBERT SPEAR REMONUMENTATION REPORT DATED 12-7-98.	<u>E-11</u> FOUND 3/4" REBAR AT FENCE CORNER AND 3 B.T.'S PER ROBERT PERKINS REMONUMENTATION REPORT DATED 11-20-98.
---	---

C. Description of monument for corner and accessories established to perpetuate locating the position of the corner:

<u>E-10</u> SET DICKINSON COUNTY MONUMENT INSIDE EXISTING PIPE WITH 4" ALUMINUM CAP NEW WITNESSES	<u>E-11</u> FOUND ABOVE DESCRIBED MONUMENT IN PLACE NEW WITNESSES
FOUND 8" BLACK SPRUCE S 62° W (M.B.) 40.45' NAIL/TAG	FOUND 9" CEDAR N58°W (M.B.) 10.95' NAIL/TAG
FOUND 8" BLACK SPRUCE S 55° E (M.B.) 31.57' NAIL/TAG	FOUND 5" BALSAM S55°E (M.B.) 17.42' NAIL/TAG
9" BLACK SPRUCE S 22°E (M.B.) 26.55' NAIL/TAG	FOUND 10" CEDAR N33°E (M.B.) 21.03' NAIL/TAG
4" TAMARACK N 7°W (M.B.) 27.05' NAIL/TAG	5" ASH SOUTH (M.B.) 26.25' NAIL/TAG
CARSONITE MARKER NORTH 0.80'	CARSONITE MARKER SOUTH 1.00'

Signed by James H. Moore
 Surveyor's Michigan License 28423

Date 11-8-99

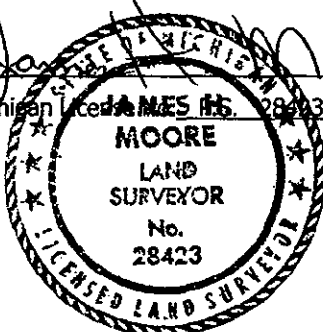

FORM APPROVED BY MICHIGAN STATE BOARD OF PROFESSIONAL SURVEYORS, JAN. 28, 1971
 REVISED MAY 14, 1975
 REVISED JAN., 1983
 REVISED OCT., 1995

ACCEPTED BY THE DICKINSON COUNTY
 SURVEY PEER GROUP AS THE OFFICIAL
 CORNER UNDER MICHIGAN PUBLIC ACT
 345 OF 1990 AT A MEETING HELD ON

11-23-99
Robert Perkins
 COUNTY REPRESENTATIVE

Liber 3 PAGE 16