

41
T40NR30W
E-13 ✓

LAND CORNER RECORDATION CERTIFICATE
Filing Requirement of Act 74, Mich. P.A. 1970

RECORDED

1998 DEC 14 PM 12:24

For corners in

Dickinson	Located in:	Corner Code #
(County)		
Breitung Twp.	T 40NR 30W	D-7
1. Public Land Survey	T R	E-1
	T R	
	T R	
	T R	
2. Property Controlling in Section	S T R	
	S T R	
3. Miscellaneous Property in Sec.	S T R	
	S T R	

SURVEY & REMONUMENTATION

NOV 15 1999

SECTION

REGISTER OF DEEDS
DICKINSON COUNTY
RON MULLER, COUNTY CLERK

Register of Deeds Stamp & File Number

4. Lot No. _____, Recorded Plat _____
5. Private Claims _____

I, Robert F. Perkins, in a field survey on Aug. 18, 1998 do hereby state that under requirements of P.A. 74, Michigan P.A. of 1970, the corner points mentioned in lines 1 and 2 above were in conformance with regulations and rules therefore as required in the current manual of survey instructions of the United States Department of the Interior, Bureau of Land Management or by a decree of a Court of Law and /or that the corner points mentioned in lines 3, 4 and 5 above were in conformance with the rules of the Michigan Board of Land Surveyors or by a Decree of a Court of Law; established, re-established, monumented, recovered, found as expressed below:

A	B	C	D	E	F	G	H	I	J	K	L	M
1												
2	6		5		4		3		2		1	
3												
4	7		8		9		10		11		12	
5												
6	18		17		16		15		14		13	
7												
8	19		20		21		22		23		24	
9												
10	30		29		28		27		26		25	
11												
12	31		32		33		34		35		36	
13												

NOTE: Not more than 2 corners, all in the same town and range, may be recorded on this certificate.

A. Description of original monument and accessories and/or subsequent restoration;

D-7 $\frac{17}{4}$ Corner Common to Sections 20
Post by James H. Mullett, D.S. 1849
Original Bearing Trees
Aspen 4" N14°W 08 Lk.
Aspen 4" S78°E 09 Lk.

E-1 North Corner Common to sections 4 & 5
Post by James H. Mullett, D.S. 1849
Original Bearing Trees
Aspen 12" S75°E 13 Lk.
Aspen 12" S20°W 24 Lk.

B. Description of corner evidence found and/or method applied in restoring or reestablishing corner:

D-7 No Evidence of Original Corner or Accessories found.
Found 1" Iron Pin referred to by E.C. Muller, P.S. in Certificate #189 dated 8-21-1978.

E-1 No Evidence of Original Corner or Accessories Found.
Found 1" Iron Pipe with 4" D.N.R. Brass Cap set by B. Buckler, RLS on 7-28-1955 and Filed on Old Corner Report No. 119.


C. Description of monument for corner and accessories established to perpetuate locating the position of the corner:

D-7 Placed 2½" Stamped D.C. Remon. Corner at above described Iron Bar.
New Witnesses:
Found 1½" Iron Pipe N88°W(M.B.) 16.35'
1978 BT's Found and Upgraded:
S.Maple 14" N27°W(M.B.) 9.52' Nail/Tag
Oak 14" N47°E(M.B.) 17.60' Nail/Tag
Oak 14" S08°E(M.B.) 25.21' Nail/Tag
Placed Carsonite Marker 0.6' North of Corner.

E-1 Found Pipe Marker as described in "B" above. Also found one 1955 BT dead.
New Witnesses:
Maple 4" S72°W(M.B.) 27.5' Nail/Tag
Maple 6" N33°W(M.B.) 12.89' Nail/Tag
Oak 10" N63°E(M.B.) 7.35' Nail/Tag
Oak 10" S29°E(M.B.) 37.48' Nail/Tag
Placed Carsonite Marker 1.0' North of Corner.

Signed by Robert F. Perkins
Surveyor's Michigan License No. 12027

Date Oct. 24, 1998

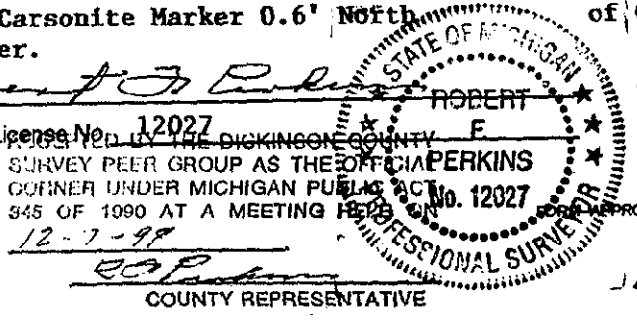

APPROVED BY THE DICKINSON COUNTY SURVEY PEER GROUP AS THE OFFICIAL CORNER UNDER MICHIGAN PUBLIC ACT 345 OF 1990 AT A MEETING HELD ON 12-7-98
APPROVED BY MICHIGAN STATE BOARD OF PROFESSIONAL SURVEYORS, JAN. 28, 1971
REVISED MAY 14, 1975
REVISED JAN., 1983
REVISED OCT., 1985

Liber 2 Page 394