

LAND CORNER RECORDATION CERTIFICATE
Filing Requirement of Act 74, Mich. P.A. 1970

RECORDED

1999 NOV 30 PM 3: 23

For corners in

DICKINSON Located In: Corner Code #
 (County)

BREITUNG TOWNSHIP

1. Public Land Survey T 41 N R 30 W F-11
 T 41 N R 30 W G-12
 T ___ R ___
 T ___ R ___

2. Property Controlling S ___ T ___ R ___
 In Section S ___ T ___ R ___

3. Miscellaneous S ___ T ___ R ___
 Property in Sec. S ___ T ___ R ___

REGISTER OF DEEDS
 DICKINSON COUNTY
 RON MOORE, CLERK

Register of Deeds Stamp & File
 Number

4. Lot No. _____, Recorded Plat _____ SECTION _____

5. Private Claims _____

I, JAMES H. MOORE, in a field survey on AUGUST 18, 19 99 do hereby state that under requirements of P.A. 74, Michigan P.A. of 1970, the corner points mentioned in lines 1 and 2 above were in conformance with regulations and rules therefore as required in the current manual of survey instructions of the United States Department of the Interior, Bureau of Land Management or by a decree of a Court of Law and/or that the corner points mentioned in lines 3, 4 and 5 above were in conformance with the rules of the Michigan Board of Land Surveyors or by a Decree of a Court of Law, established, re-established, monumented, recovered, found as expressed below:

	A	B	C	D	E	F	G	H	I	J	K	L	M
1													
2	6			5			4			3			1
3													
4	7			8			9			10			12
5													
6	18			17			16			15			12
7													
8	19			20			21			22			24
9													
10	30			29			28			27			25
11							●						
12	31			32			●			34			36
13													

NOTE: Not more than 2 corners, all in the same town and range, may be recorded on this certificate.

A. Description of original monument and accessories and/or subsequent restoration:

<u>F-11</u> 1/4 CORNER COMMON TO SECTIONS 28 - 33 SPRUCE POST BY JOHN BURT D.S. 1849 SPRUCE 5" N 51° E 17 LINKS SPRUCE 5" S 32° W 18 LINKS	<u>G-12</u> 1/4 CORNER COMMON TO SECTIONS 33 - 34 CEDAR POST BY JOHN BURT D.S. 1849 CEDAR 10" S 57° E 13 LINKS WHITE BIRCH 30" N 67° W 08 LINKS
---	--


B. Description of corner evidence found and/or method applied in restoring or reestablishing corner:

<u>F-11</u> FOUND RAIL ROAD SPIKE AT CENTERLINE OF ROAD. PER ROBERT SPEAR REMONUMENTATION REPORT DATED 12-7-98.	<u>G-12</u> FOUND 5/8" IRON PIN WITH ONE EXISTING B.T. PER ROBERT PERKINS REMONUMENTATION REPORT DATED 11-20-98
---	---

C. Description of monument for corner and accessories established to perpetuate locating the position of the corner:

<u>F-11</u> ACCEPTED RAILROAD SPIKE AS BEST AVAILABLE EVIDENCE AND LEFT RR SPIKE IN PLACE AS THE MONUMENT. NEW WITNESSES: 14" RED PINE S 41° E (M.B.) 56.39' NAIL/TAG 8" TAMARACK S 56° W (M.B.) 66.42' NAIL/TAG EX. POWER POLE N 80° W (M.B.) 30.64' FD NAIL/TAG EX. 21" RED PINE N 70° E (M.B.) 40.98' FD NAIL/TAG CARSONITE MARKER EAST 32.3' ALUM. REF. MON. EAST 31.77' ALUM. REF. MON. W/RAIL WEST 31.88'	<u>G-12</u> SET DICKINSON COUNTY MONUMENT WITH STAMPED 4" ALUMINUM CAP. NEW WITNESSES: FOUND 9" BALSAM S 84° E (M.B.) 23.75' NAIL/TAG 4" WHITE BIRCH N 54° W (M.B.) 35.96' NAIL/TAG 3" CHERRY S 87° W (M.B.) 9.96' NAIL/TAG 9" BALSAM S 42° W (M.B.) 57.67' NAIL/TAG 6" ASPEN S 12° W (M.B.) 26.30' NAIL/TAG CARSONITE MARKER NORTH 1.00'
--	---

Signed by James H. Moore Date 11-3-99
 Surveyor's Michigan License No. P.S. 28423

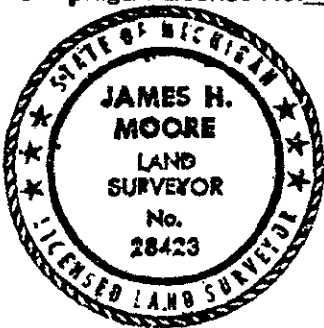

FORM APPROVED BY MICHIGAN STATE BOARD OF PROFESSIONAL SURVEYORS, JAN. 28, 1971
 ACCEPTED BY THE DICKINSON COUNTY SURVEY PEER GROUP AS THE OFFICIAL CORNER UNDER MICHIGAN PUBLIC ACT 345 OF 1990 AT A MEETING HELD ON 11-23-99
Robert Perkins
 COUNTY REPRESENTATIVE

REVISED MAY 14, 1975
 REVISED JAN., 1983
 REVISED OCT., 1995

Liber 3 Page 10