

LAND CORNER RECORDATION CERTIFICATE
Filing Requirement of Act 74, Mich. P.A. 1970

RECORDED

1999 NOV 30 PM 3:23

For corners in

DICKINSON
(County)

Located In:

Corner Code #

BREITUNG TOWNSHIP

1. Public Land Survey

T 41 N R 30 W

F-11

T 41 N R 30 W

G-12

T R

T R

S T R

2. Property Controlling in Section

S T R

S T R

3. Miscellaneous Property In Sec.

S T R

S T R

MAR 24 2000

REGISTER OF DEEDS
 DICKINSON COUNTY
 RON MOORE 1011 11 4990

Register of Deeds Stamp & File Number

4. Lot No. _____, Recorded Plat _____ SECTION _____

5. Private Claims _____

I, JAMES H. MOORE, in a field survey on AUGUST 18, 19 99 do hereby state that under requirements of P.A. 74, Michigan P.A. of 1970, the corner points mentioned in lines 1 and 2 above were in conformance with regulations and rules therefore as required in the current manual of survey instructions of the United States Department of the Interior, Bureau of Land Management or by a decree of a Court of Law and /or that the corner points mentioned in lines 3, 4 and 5 above were in conformance with the rules of the Michigan Board of Land Surveyors or by a Decree of a Court of Law; established, re-established, monumented, recovered, found as expressed below:

	A	B	C	D	E	F	G	H	I	J	K	L	M
1													
2	6		5		4		3		2		1		
3													
4	7		8		9		10		11		12		
5													
6	18		17		16		15		14		13		
7													
8	19		20		21		22		23		24		
9													
10	30		29		28		27		26		25		
11													
12	31		32		33		34		35		36		
13													

NOTE: Not more than 2 corners, all in the same town and range, may be recorded on this certificate.

A. Description of original monument and accessories and/or subsequent restoration:

F-11 1/4 CORNER COMMON TO SECTIONS 28 - 33
 SPRUCE POST BY JOHN BURT D.S. 1849
 SPRUCE 5" N 51° E 17 LINKS
 SPRUCE 5" S 32° W 18 LINKS

G-12 1/4 CORNER COMMON TO SECTIONS 33 - 34
 CEDAR POST BY JOHN BURT D.S. 1849
 CEDAR 10" S 57° E 13 LINKS
 WHITE BIRCH 30" N 67° W 08 LINKS

B. Description of corner evidence found and/or method applied in restoring or reestablishing corner:

F-11 FOUND RAIL ROAD SPIKE AT CENTERLINE OF ROAD.
 PER ROBERT SPEAR REMONUMENTATION REPORT
 DATED 12-7-98.

G-12 FOUND 5/8" IRON PIN WITH ONE EXISTING B.T.
 PER ROBERT PERKINS REMONUMENTATION REPORT
 DATED 11-20-98

C. Description of monument for corner and accessories established to perpetuate locating the position of the corner:

F-11 ACCEPTED RAILROAD SPIKE AS BEST AVAILABLE
 EVIDENCE AND LEFT RR SPIKE IN PLACE AS
 THE MONUMENT. NEW WITNESSES:

G-12 SET DICKINSON COUNTY MONUMENT WITH STAMPED 4"
 ALUMINUM CAP.
 NEW WITNESSES:


14" RED PINE S 41° E (M.B.) 56.39' NAIL/TAG
 8" TAMARACK S 56° W (M.B.) 66.42' NAIL/TAG
 EX. POWER POLE N 80° W (M.B.) 30.64' FD NAIL/TAG
 EX. 21" RED PINE N 70° E (M.B.) 40.98' FD NAIL/TAG
 CARSONITE MARKER EAST 32.3'
 ALUM. REF. MON. EAST 31.77'
 ALUM. REF. MON. W/RAIL WEST 31.88'

FOUND 9" BALSAM S 84° E (M.B.) 23.75' NAIL/TAG
 4" WHITE BIRCH N 54° W (M.B.) 35.96' NAIL/TAG
 3" CHERRY S 87° W (M.B.) 9.96' NAIL/TAG
 9" BALSAM S 42° W (M.B.) 57.67' NAIL/TAG
 6" ASPEN S 12° W (M.B.) 26.30' NAIL/TAG
 CARSONITE MARKER NORTH 1.00'

Signed by James H. Moore

Date 11-8-99

Surveyor's Michigan License No. P.S. 28423

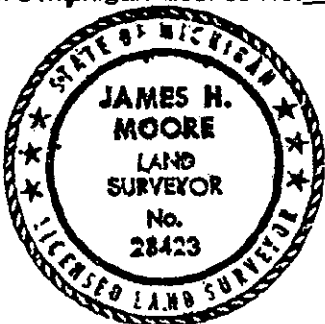

FORM APPROVED BY MICHIGAN STATE BOARD OF PROFESSIONAL SURVEYORS, JAN. 28, 1971
 ACCEPTED BY THE DICKINSON COUNTY SURVEY PEER GROUP AS THE OFFICIAL CORNER UNDER MICHIGAN PUBLIC ACT 345 OF 1990 AT A MEETING HELD ON 11-23-99
Robert Perkins
 COUNTY REPRESENTATIVE

REVISED MAY 14, 1975
 REVISED JAN., 1983
 REVISED OCT., 1996

Liber 3 Page 10