

RECORDED

LAND CORNER RECORDATION CERTIFICATE  
Filing Requirement of Act 74, Mich. P.A. 1970

1998 DEC 14 PM 12:25

For corners in

|                                    |                   |               |
|------------------------------------|-------------------|---------------|
| <u>Dickinson</u>                   | Located In:       | Corner Code # |
| (County)<br>Sagola Twp.            |                   |               |
| 1. Public Land Survey              | T <u>41NR 30W</u> | <u>E-4</u>    |
|                                    | T ___ R ___       | <u>H-5</u>    |
|                                    | T ___ R ___       |               |
|                                    | T ___ R ___       |               |
| 2. Property Controlling in Section | S ___ T ___ R ___ |               |
|                                    | S ___ T ___ R ___ |               |
| 3. Miscellaneous Property in Sec.  | S ___ T ___ R ___ |               |
|                                    | S ___ T ___ R ___ |               |

REGISTER OF DEEDS  
DICKINSON COUNTY  
DON MOHR, CLERK

Register of Deeds Stamp & File Number

SECTION

4. Lot No. \_\_\_\_\_, Recorded Plat \_\_\_\_\_  
5. Private Claims \_\_\_\_\_

I, Robert F. Perkins, in a field survey on Oct. 23, 1998 do hereby state that under requirements of P.A. 74, Michigan P.A. of 1970, the corner points mentioned in lines 1 and 2 above were in conformance with regulations and rules therefore as required in the current manual of survey instructions of the United States Department of the Interior, Bureau of Land Management or by a decree of a Court of Law and/or that the corner points mentioned in lines 3, 4 and 5 above were in conformance with the rules of the Michigan Board of Land Surveyors or by a Decree of a Court of Law; established, re-established, monumented, recovered, found as expressed below:

NOTE: Not more than 2 corners, all in the same town and range, may be recorded on this certificate.

| A  | B  | C  | D  | E  | F  | G  | H | I | J | K | L | M |
|----|----|----|----|----|----|----|---|---|---|---|---|---|
| 1  |    |    |    |    |    |    |   |   |   |   |   |   |
| 2  | 6  | 5  | 4  | 3  | 2  | 1  |   |   |   |   |   |   |
| 3  |    |    |    |    |    |    |   |   |   |   |   |   |
| 4  | 7  | 8  | 9  | 10 | 11 | 12 |   |   |   |   |   |   |
| 5  |    |    |    |    |    |    |   |   |   |   |   |   |
| 6  | 18 | 17 | 16 | 15 | 14 | 13 |   |   |   |   |   |   |
| 7  |    |    |    |    |    |    |   |   |   |   |   |   |
| 8  | 19 | 20 | 21 | 22 | 23 | 24 |   |   |   |   |   |   |
| 9  |    |    |    |    |    |    |   |   |   |   |   |   |
| 10 | 30 | 29 | 28 | 27 | 26 | 25 |   |   |   |   |   |   |
| 11 |    |    |    |    |    |    |   |   |   |   |   |   |
| 12 | 31 | 32 | 33 | 34 | 35 | 36 |   |   |   |   |   |   |
| 13 |    |    |    |    |    |    |   |   |   |   |   |   |

A. Description of original monument and accessories and/or subsequent restoration:

E-4 1/4 Corner Common to Sections 8/9  
Post by John Burt, D.S. 1849  
Original Bearing Trees  
Lynn 20" S62°E 15 Lk.  
Hemlock 8" N34°W 23 Lk.

H-5 1/4 Corner Common to Sections 10/15  
Post by John Burt, D.S. 1849  
Original Bearing Trees  
Spruce 12" N20°W 17 Lk.  
Spruce 10" S35°E 15 Lk.

B. Description of corner evidence found and/or method applied in restoring or reestablishing corner:

E-4 No Evidence of Original Corner or Accessories Found.  
Found 1" Iron Pipe with 4" D.N.R. Brass Cap Set by Billy D. Buckler, RLS in 7-17-1962 (Old Corner Report #734)  
1962 Bearing Trees:  
Maple 5" N6°W 19 Lk. (Found)  
Maple 5" S88°E 36 1/2 Lk. (Found)

H-5 Found 5/8" x 24" Iron Bar Set in 1977 by the undersigned from 2 Spruce BT Stumps (Badly decayed) at Blazed Line running East.  
1977 Bearing Trees:  
Cedar 6" N43°E 31.85'  
Balsam 5" S53°W 16.90'


C. Description of monument for corner and accessories established to perpetuate locating the position of the corner:

E-4 Found and Accepted Pipe Monument described in "B" above.  
New Witnesses:  
Sugar Maple 10" N06°W(M.B.) 12.44' Nail/Tag  
Sugar Maple 12" N63°W(M.B.) 9.76' Nail/Tag  
Sugar Maple 4" S32°W(M.B.) 7.34' Nail/Tag  
Sugar Maple 12" S88°E(M.B.) 23.95' Nail/Tag  
Placed Carsonite Marker 1.0' North

H-5 Accepted Iron Bar described in "B" above as Best Available Evidence of Corner Location. Replaced Existing Iron Bar with 2 1/2" Stamped D.C. Remon. Corner.  
New Witnesses:  
Cedar 8" N42°E(M.B.) 31.75' Nail/Tag  
Cedar 7" N77°E(M.B.) 37.34' Nail/Tag  
Fir 4" S74°W(M.B.) 22.97' Nail/Tag  
Spruce 4" S38°E(M.B.) 10.40' Nail/Tag  
Placed Carsonite Marker 0.8' East.

Signed by Robert F. Perkins  
Surveyor's Michigan License No. 12027

Date Nov. 20, 1998

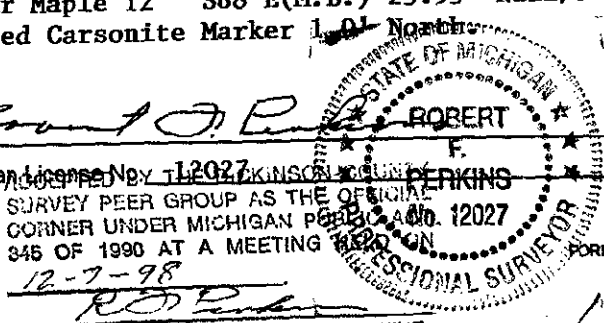

FORM APPROVED BY MICHIGAN STATE BOARD OF PROFESSIONAL SURVEYORS, JAN. 28, 1971  
REVISED MAY 14, 1975  
REVISED JAN., 1983  
REVISED OCT., 1985

Liber 2 Page 411