

MAY 07 1997

COMMISSION

LAND CORNER RECORDATION CERTIFICATE
Filing Requirement of Act 74, Mich. P.A. 1970

RECORDED
1996 DEC 18 AM 11:16

For corners in

DICKINSON
(County)
SAGOLA TWP.

Located In:

Corner Code #

- | | | | | | |
|--------------------------------------|---|------------|---|------------|--------------|
| 1. Public Land Survey | T | <u>41N</u> | R | <u>30W</u> | <u>1-7</u> ✓ |
| | T | _____ | R | _____ | _____ |
| | T | _____ | R | _____ | _____ |
| | T | _____ | R | _____ | _____ |
| 2. Property Controlling in Section | S | _____ | T | _____ | _____ |
| | S | _____ | T | _____ | _____ |
| 3. Miscellaneous Property in Section | S | _____ | T | _____ | _____ |
| | S | _____ | T | _____ | _____ |
4. Lot No. _____, Recorded Plat _____
5. Private Claims _____

REGISTER OF DEEDS
DICKINSON COUNTY
IRON MOUNTAIN, MI 49801

Register of Deeds Stamp & File Number

	A	B	C	D	E	F	G	H	I	J	K	L	M
2	6		5		4		3		2		1		
3													
4	7		8		9		10		11		12		
5													
6	18		17		16		15		14		13		
7								●					
8	19		20		21		22		23		24		
9													
10	30		29		28		27		26		25		
11													
12	31		32		33		34		35		36		
13													

I, ROBERT F. PERKINS, in a field survey on 6-25, 19 96, do hereby certify that under requirements of P.A. 74, Michigan P.A. of 1970, the corner points mentioned in lines 1 and 2 above were in conformance with regulations and rules therefore as required in the current manual of survey instructions of the United States Department of the Interior, Bureau of Land Management or by a decree of a Court of Law and/or that the corner points mentioned in lines 3, 4 and 5 above were in conformance with the rules of the Michigan Board of Professional Surveyors or by a Decree of a Court of Law; established, re-established, monumented, re-monumented, recovered, found as expressed below:

NOTE: Not more than 4 corners, all in the same town and range, may be recorded on this certificate.

A. Description of original monument and accessories and/or subsequent restoration:

1-7 SECTION CORNER COMMON TO SECTIONS 14-15-22-23
POST BY J. MULLETT, D.S. 1849
ORIGINAL BEARING TREES
TAMARACK 8" N52°W 30 L.
SPRUCE 4" S40°E 85 L.


B. Description of corner evidence found and/or method applied in restoring or reestablishing corner:

1-7 CORNER #815 OLD FILING SYSTEM
BY MICHIGAN STATE HIGHWAY DEPT.
NO EVIDENCE OF ORIGINAL CORNER
OR ACCESSORIES FOUND.
FOUND 1" IRON PIPE IN ANCIENT
EAST-WEST FENCE LINE.
CORNER HAS BEEN IN PLACE OVER 40
YEARS AND HAS BEEN ACCEPTED AND
USED ON NUMEROUS SURVEYS.

ACCEPTED BY THE DICKINSON COUNTY
SURVEY PEER GROUP AS THE OFFICIAL
CORNER UNDER MICHIGAN PUBLIC ACT
345 OF 1990 AT A MEETING HELD ON
12-17-96
R.O.P.
COUNTY REPRESENTATIVE

C. Description of monument for corner and accessories established to perpetuate locating the position of the corner:

1-7 ACCEPTED ABOVE PIPE AS BEST REMAINING
EVIDENCE OF CORNER LOCATION.
SET 2½" D.C. REMON. STAMPED CAP INSIDE
OF EXISTING PIPE.
NEW BEARING TREES:
⊙ BLACK SPRUCE 3" N22°W (M.B.) 10.6'
⊙ BLACK SPRUCE 3" S68°E (M.B.) 14.3'
TAMARACK 5" S63°W (M.B.) 14.11'
TAMARACK 5" N49°W (M.B.) 50.96'
⊙ STEEL TOWER LINE EAST 60'
SET 3" SQUARE WOOD POST AT CORNER.

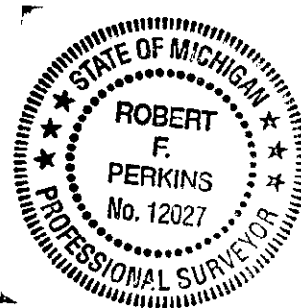

Signed by Robert F. Perkins

Date DECEMBER 2, 1996

Surveyor's Michigan License No. 12027

FORM APPROVED BY MICHIGAN STATE BOARD OF PROFESSIONAL SURVEYORS, JAN. 28, 1971
REVISED MAY 14, 1975
REVISED JAN., 1983