

SURVEY & REMONUMENTATION

NOV 15 1999

RECORDED

1997 OCT -9 AM 8:21

LAND CORNER RECORDATION CERTIFICATE

Filing Requirement of Act 74, Mich. P.A. 1970

SECTION

For corners in

Dickinson

(County)

Breitung Twp.

Located In:

Corner Code #

- | | | | | | |
|--------------------------------------|---|------------|---|------------|--------------|
| 1. Public Land Survey | T | <u>41N</u> | R | <u>30W</u> | <u>K-9</u> ✓ |
| | T | ___ | R | ___ | <u>L-9</u> |
| | T | ___ | R | ___ | ___ |
| | T | ___ | R | ___ | ___ |
| 2. Property Controlling in Section | S | ___ | T | ___ | ___ |
| | S | ___ | T | ___ | ___ |
| 3. Miscellaneous Property in Section | S | ___ | T | ___ | ___ |
| | S | ___ | T | ___ | ___ |

REGISTER OF DEEDS
DICKINSON COUNTY
RON MORTIMER, CLERK

Register of Deeds Stamp & File Number

4. Lot No. _____, Recorded Plat _____
5. Private Claims _____

	A	B	C	D	E	F	G	H	I	J	K	L	M
2	6		5		4		3		2		1		
3													
4	7		8		9		10		11		12		
5													
6	18		17		16		15		14		13		
7													
8	19		20		21		22		23		24		
9											●	●	
10	30		29		28		27		26		25		
11													
12	31		32		33		34		35		36		
13													

I, R.F. Perkins, in a field survey on Sept. 19, 1997, do hereby certify that under requirements of P.A. 74, Michigan P.A. of 1970, the corner points mentioned in lines 1 and 2 above were in conformance with regulations and rules therefore as required in the current manual of survey instructions of the United States Department of the Interior, Bureau of Land Management or by a decree of a Court of Law and/or that the corner points mentioned in lines 3, 4 and 5 above were in conformance with the rules of the Michigan Board of Professional Surveyors or by a Decree of a Court of Law; established, re-established, monumented, re-monumented, recovered, found as expressed below:

NOTE: Not more than 4 corners, all in the same town and range, may be recorded on this certificate.

A. Description of original monument and accessories and/or subsequent restoration:

- | | |
|---|---|
| K-9 Northwest Corner, Section 25
Post by John Burt, D.S. 1849
Original Bearing Trees
Hemlock 22" S12°W 17 Lks.
Lynn 16" N88°E 22 Lks. | L-9 North ½ Corner, Section 25
Post by John Burt, D.S. 1849
Original Bearing Trees
Sugar 14" N78°E 27 Lks.
Y. Birch 18" S56°W 50 Lks. |
|---|---|

ACCEPTED BY THE DICKINSON COUNTY SURVEY PEER GROUP AS THE OFFICIAL CORNER UNDER MICHIGAN PUBLIC ACT 345 OF 1990 AT A MEETING HELD ON 10-7-97


B. Description of corner evidence found and/or method applied in restoring or reestablishing corner:

- | | |
|--|--|
| K-9 No evidence of Original Corner or Accessories Found.
Section 25 Subdivided by W.C. Johnson, C.E. D.C.R.C. in 1937. See Map in File A-10, No. 23B for details of Survey.
Corner Re-established using Johnson's Distances to Section Corner 1 Mile East and ½ Corner ½ Mile South. Old blue line runs South from this Location | L-9 No evidence of Original Corner or Accessories Found.
Section 25 Subdivided by W.C. Johnson, C.E., D.C.R.C. in 1937. See Map in File A-10, No. 23B for details of Survey. Corner Re-established at Mid-Point on Line between Northeast and Northwest Corners of Section in harmony with 1937 Survey. |
|--|--|

C. Description of monument for corner and accessories established to perpetuate locating the position of the corner:

- | | |
|---|---|
| K-9 Set 2½" Stamped D.C. Remon. Monument.
New Witnesses
W.Pine 30" N47°E (M.B.) 45.40'
R.Maple 8" S37°E (M.B.) 7.05'
R.Maple 6" N77°W (M.B.) 13.95'
R.Maple 8" N24°E (M.B.) 21.05'
Placed Carsonite Marker 1.0' North | L-9 Set 2½" Stamped D.C. Remon. Monument.
New Witnesses
Maple 14" N9°E (M.B.) 14.5'
Ironwood 7" East (M.B.) 18.54'
S.Maple 6" N45°E (M.B.) 18.84'
S.Maple 8" S12°W (M.B.) 77.62'
53' Southeasterly to Woods Road N50°W
Placed Carsonite Marker 1.0' North. |
|---|---|

Signed by Robert F. Perkins
ROBERT F. PERKINS
Surveyor's Michigan License No. 12027

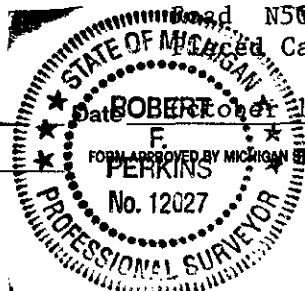

Date Oct 11, 1997
FORM APPROVED BY MICHIGAN STATE BOARD OF PROFESSIONAL SURVEYORS, JAN. 28, 1971
REVISED MAY 14, 1975
REVISED JAN., 1983

LIBERATED PAGE