


LAND CORNER RECORDATION CERTIFICATE
 Filing Requirement of Act 74, Mich. P.A. 1970

For corners in
Dickinson
 (County)

	Located In:	Corner Code #
1. Public Land Survey	T 41N R 30W	M3
	T 41N R 30W	M1
	T _____ R _____	_____
2. Property Controlling in Section	S 1 T 41N R 30W	1
	S _____ T _____ R _____	_____
3. Miscellaneous Property in Sec.	S _____ T _____ R _____	_____
	S _____ T _____ R _____	_____
4. Lot No. _____, Recorded Plat _____		
5. Private Claims _____		

Register of Deeds Stamp & File Number

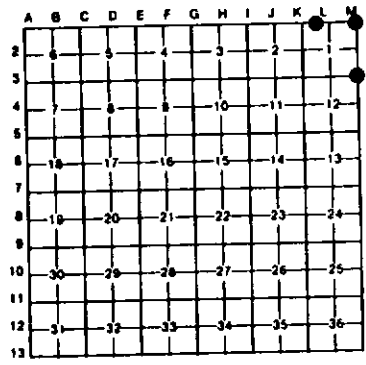

I, Stephan J. Szyszkoski, in a field survey on September 02, 1992, 19____, do hereby certify that under requirements of P.A. 74, Michigan P.A. of 1970, the corner points mentioned in lines 1 and 2 above were in conformance with regulations and rules therefore as required in the current manual of survey instructions of the United States Department of the Interior, Bureau of Land Management or by a decree of a Court of Law and/or that the corner points mentioned in lines 3, 4 and 5 above were in conformance with the rules of the Michigan Board of Land Surveyors or by a Decree of a Court of Law, established, re-established, monumented, re-monumented, recovered, found as expressed below:

NOTE: Not more than 4 corners, all in the same town and range, may be recorded on this certificate.

A. Description of original monument and accessories and/or subsequent restoration:
 (M3) Section corner common to Sections 1-12, T41N-R30W and Sections 6-7, T41N-R29W. Corner established by U.S. Deputy Surveyor Wm.A. Burt, 1849. Original BTs: W. Birch 10 S17W 25, Spruce 9 N28E 23, W. Pine 10 S08E 26, Spruce 10 N16W 48. Original record shows the following line calls: 1) West 2.00 later swamp C.S.E., 2) North 1.9 Ascend Ledge of Granite 15 ft. high, 3) South 0.5 Ascend (from south) Ledge Syenitic Granite 20 feet, 4) South 1.5 Hornblend slate in ledge 15 feet high C.N.W., 5) East 3.00 Top of ledge 25 feet N.W.
 (M1) Corner to townships 41N & 42N, 29 & 30W. Corner established by U.S. Deputy Surveyor Wm.A. Burt, 1849. Original BTs: Y. Birch 8 N18E 14, Lynn 10 S50W 18. Corner shown on survey by Gary L. Pisoni, R.L.S., Dated Sept. 10, 1986 as an iron pipe in concrete.
 (1) West 1/16 between Section 1 T41N-R30W, and Section 36, T42N-R30W. Corner not established in original survey. Found no subsequent record.

B. Description of corner evidence found and/or method applied in restoring or reestablishing corner:
 (M3) Original post and accessories not recovered. Found and accepted a 1" pipe with a 3" brass cap, stamped into quadrants, set in concrete, apparently placed by Hanna Mining Co. engineers, in accord with the original record as referenced above: 1) Checks to well-defined swamp edge, C. SW. 2) Checks. 3) Checks to top of a ledge. 4) Checks to a 15 foot high ledge, C. N.W., 5) Checks. Distances to recorded corners one mile east and west measure 1.7 ch. short, and 2.6 ch. long, respectively, when compared to the original record, the original record probably being erroneous.
 (M1) Original post and accessories not recovered. Found and accepted a 1" iron pipe set in concrete, assumed to have been placed by Hanna Mining Co. engineers. Distances east, west, and south to reestablished corners check well with the original record.
 (1) Found a 1" drill rod placed by unknown persons 0.10' south and 0.52' west of the midpoint between M1 and M3, and accepted this monument as a careful and faithful determination of the corner.

C. Description of monument for corner and accessories established to perpetuate locating the position of the corner.

(M3) Found 1" pipe with 3" brass cap. Blazed and scribed the following new bearing trees: 14" N. Pine N72W 40.8' (S1 NBT) 12" W. Pine S09E 40.6' (S7 NBT) 14" N. Pine N53E 45.9' (S6 NBT) Aluminum pipe, projecting 8 feet, S06W, 3.0'	(M1) Found iron pipe in concrete. Set MDNR tag in U.N.P. Co. Power pole #85867 S03W 50.10' 6" pipe S50E 0.4' 5" Aspen S88W 4.3' (S1 NBT) with location poster North 2' base of poor rock pile.	(1) Found 1" drill rod. Blazed and scribed the following new bearing trees: 4" Sugar S02E 7.0' (1/16S BT) 8" Sugar S59W 11.7' (1/16S BT) 5" Sugar N34W 22.8' (1/16S BT) 5" Sugar N15E 0.1' (1/16S BT)
--	---	---

Signed by Stephan J. Szyszkoski Date 1-12-93
 Surveyor's Michigan License No. 33986

