

A-7/M-7 T41N R30W
K-1/K-13 T42N R29W

LAND CORNER RECORDATION CERTIFICATE
Filing Requirement of Act 74, Mich. P.A. 1970

RECORDED

1999 NOV 30 PM 3:31

For corners in

DICKINSON
(County)

Located In:

Corner Code #

NORWAY TOWNSHIP

1. Public Land Survey

T 41 N R 29 W

A-7

T 41 N R 29 W

K-1

T R

T R

2. Property Controlling
in Section

S T

T R

S T

T R

3. Miscellaneous
Property in Sec.

S T

T R

S T

T R

SURVEY &
REMONUMENTATION

REGISTER OF DEEDS
DICKINSON COUNTY
RON MOORE

Register of Deeds Stamp & File
Number

MAR 24 2000

4. Lot No. _____, Recorded Plat _____

SECTION

5. Private Claims _____

I, JAMES H. MOORE, in a field survey on OCTOBER 6 & 21, 19 99 do hereby state that under requirements of P.A. 74, Michigan P.A. of 1970, the corner points mentioned in lines 1 and 2 above were in conformance with regulations and rules therefore as required in the current manual of survey instructions of the United States Department of the Interior, Bureau of Land Management or by a decree of a Court of Law and/or that the corner points mentioned in lines 3, 4 and 5 above were in conformance with the rules of the Michigan Board of Land Surveyors or by a Decree of a Court of Law; established, re-established, monumented, recovered, found as expressed below:

NOTE: Not more than 2 corners, all in the same town and range, may be recorded on this certificate.

	A	B	C	D	E	F	G	H	I	J	K	L	M
1													
2	6		5		4		3		2		1		
3													
4	7		8		9		10		11		12		
5													
6	18		17		16		15		14		13		
7													
8	19		20		21		22		23		24		
9													
10	30		29		28		27		26		25		
11													
12	31		32		33		34		35		36		
13													

A. Description of original monument and accessories and/or subsequent restoration:

A-7 CORNER COMMON TO SECTIONS 18-19 (T41N-R29W) AND SECTIONS 13-24 (T41N-R30W)
TAMARACK POST BY AUSTIN BURT D.S. 1847
TAMARACK 11" S 49° W 17 LINKS
TAMARACK 10" N 12° E 21 LINKS

K-1 CORNER COMMON TO SECTIONS 1 AND 2 (T41N R29W) AND SECTIONS 35 AND 36 (T42N R29W)
CEDAR POST BY AUSTIN BURT, D.S. 1846
CEDAR 14" N 79° E 37 LINKS
LYNN 8" N 79° W 23 LINKS

B. Description of corner evidence found and/or method applied in restoring or reestablishing corner:

A-7 FOUND 1" PIPE WITH 4" MICHIGAN DEPARTMENT OF CONSERVATION BRASS CAP, SET BY DEAN DE LA MATER R.L.S. #13030.

K-1 FOUND SQUARE / SCRIBED POST. 4" MICHIGAN DEPARTMENT OF CONSERVATION MONUMENT NOT FOUND, SET BY BILL BUCKLER R.L.S. #08887.

1953 BEARING TREES
12" SPRUCE S 27° W 47 LINKS
18" CEDAR S 13° E 72 LINKS

1960 BEARING TREES
6" ASPEN S 84° W 119 1/2 LINKS
24" YELLOW PINE N 39° E 48 LINKS

C. Description of monument for corner and accessories established to perpetuate locating the position of the corner:


A-7 FOUND ABOVE DESCRIBED MONUMENT IN PLACE.
NEW WITNESSES

K-1 SET DICKINSON COUNTY 4" ALUMINUM CAP USING 1960 B.T. STUMPS. MONUMENT FALLS ON SOUTH SIDE OF FOUND SCRIBED POST. NEW WITNESSES.

FOUND 13" BLACK SPRUCE S 30° W (M.B.) 30.61' NAIL/TAG
FOUND 12" TWIN CEDARS S 10° E (M.B.) 48.24' NAIL/TAG
9" BLACK SPRUCE S 80° W (M.B.) 33.85' NAIL/TAG
8" BLACK SPRUCE N 36° W (M.B.) 43.49' NAIL/TAG
CARSONITE MARKER WEST 0.50'

10" ASPEN S 72° E (M.B.) 13.93' NAIL/TAG
8" SUGAR S 08° W (M.B.) 35.25' NAIL/TAG
9" SUGAR S 51° W (M.B.) 25.63' NAIL/TAG
8" BALSAM N 64° W (M.B.) 29.71' NAIL/TAG
CARSONITE MARKER NORTH 1.0'

Signed by _____
Surveyor's Michigan License No. _____

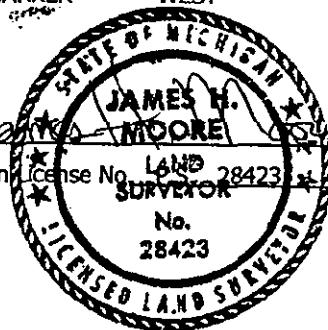

Date 11-8-99

ACCEPTED BY THE DICKINSON COUNTY
FORM APPROVED BY MICHIGAN STATE BOARD OF PROFESSIONAL SURVEYORS, JAN. 28, 1971
CORNER UNDER MICHIGAN PUBLIC ACT
346 OF 1960 AT A MEETING HELD ON
11-23-99
Robert J. Pinkerton
COUNTY REPRESENTATIVE

REVISED MAY 14, 1975
REVISED JAN., 1983
REVISED OCT., 1995

Liber 3

Page 1