29.

LAND CORNER RECORDATION CERTIFICATE

Filing Requirement of Act 74, Mich. P.A. 1970

For corners in Dickinson (County)

	Located in:	Corner Code ##
1. Public Land Survey	T 42N R 27W	E6
	T ___ R ___	
	T ___ R ___	
	T ___ R ___	
2. Property Controlling	S ___ T ___ R ___	
in Section	S ___ T ___ R ___	
3. Miscellaneous	S ___ T ___ R ___	
Property in Sec.	S ___ T ___ R ___	

Register of Deeds Stamp & File Number

4. Lot No. _____ , Recorded Plat _____
5. Private Claims _____

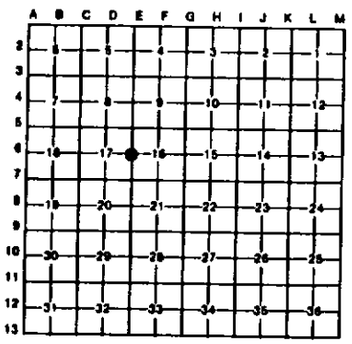

I, Stephan J. Szyszkoski , in a field survey on August 01, 1994 , 19 _____ , do hereby certify that under requirements of P.A. 74, Michigan P.A. of 1970, the corner points mentioned in lines 1 and 2 above were in conformance with regulations and rules therefore as required in the current manual of survey instructions of the United States Department of the Interior, Bureau of Land Management or by a decree of a Court of Law and/or that the corner points mentioned in lines 3, 4 and 5 above were in conformance with the rules of the Michigan Board of Land Surveyors or by a Decree of a Court of Law; established, re-established, monumented, re-monumented, recovered, found as expressed below:

NOTE: Not more than 4 corners, all in the same town and range, may be recorded on this certificate.

A. Description of original monument and accessories and/or subsequent restoration:

(E6) Quarter corner common to Sections 16-17. Corner remonumented in 1951 by Dean C. DeLaMater. Monumented from original BT in fair condition. 1" pipe with 4" brass cap at the corner witnessed by 8" Cedar S65E 19 links, 8" Cedar S20W 32 links. Found no subsequent record.

B. Description of corner evidence found and/or method applied in restoring or reestablishing corner:

(E6) Found the 1951 monument in good condition. The cedar NBTs were both down. Left the monument in place and made 4 new witnesses as described below.

C. Description of monument for corner and accessories established to perpetuate locating the position of the corner:

(E6) Found 1" pipe with 4" brass cap. Blazed and scribed the following new bearing trees:
5" Spruce N18W 106.2' "1/4S NBT"
15" dead Cedar on top of old beaver dam S58W 34.7' "1/4S NBT"
Found a piece of 1 1/2" PVC pipe set vertically in top of beaver dam S23W 46.3'. Placed a 4" squared cedar post S80W 1.5'. Bearings are magnetic.

STATE OF MICHIGAN
STEPHAN J. SZYSZKOSKI
LAND SURVEYOR
No. 33986
LICENSED LAND SURVEYOR

Signed by Stephan J. Szyszkoski Date 9-21-94

Surveyor's Michigan License No. 33986

For the Michigan Department of Natural Resources - Forest Management Division.

FORM APPROVED BY MICHIGAN STATE BOARD OF LAND SURVEYORS, JAN. 20, 1971
REVISED MAY 14, 1979
REVISED JAN., 1983