

**SURVEY &
REMONUMENTATION**

MAR 03 1998

RECORDED

LAND CORNER RECORDATION CERTIFICATE

Filing Requirement of Act 74, Mich. P.A. 1970 1997 NOV 13 AM 9:31

SECTION

For corners in

<u>Dickinson</u>	Located In:	Corner Code #
(County)		
Felch Twp.		
1. Public Land Survey	T <u>42N</u> R <u>28W</u>	<u>D-11</u>
	T ___ R ___	_____
	T ___ R ___	_____
	T ___ R ___	_____
	T ___ R ___	_____
2. Property Controlling in Section	S ___ T ___ R ___	_____
	S ___ T ___ R ___	_____
3. Miscellaneous Property in Sec.	S ___ T ___ R ___	_____
	S ___ T ___ R ___	_____

REGISTER OF DEEDS
DICKINSON COUNTY
IRON MOUNTAIN, MICHIGAN

Register of Deeds Stamp & File Number

4. Lot No. _____, Recorded Plat _____
5. Private Claims _____

I, Ewart C. Muller, in a field survey on October 15, 1997 do hereby state that under requirements of P.A. 74, Michigan P.A. of 1970, the corner points mentioned in lines 1 and 2 above were in conformance with regulations and rules therefore as required in the current manual of survey instructions of the United States Department of the Interior, Bureau of Land Management or by a decree of a Court of Law and/or that the corner points mentioned in lines 3, 4 and 5 above were in conformance with the rules of the Michigan Board of Land Surveyors or by a Decree of a Court of Law; established, re-established, monumented, recovered, found as expressed below:

NOTE: Not more than 2 corners, all in the same town and range, may be recorded on this certificate.

Surveyed by J.Burt 1850

	A	B	C	D	E	F	G	H	I	J	K	L	M
1													
2	6		5		4		3		2		1		
3													
4	7		8		9		10		11		12		
5													
6	18		17		16		15		14		13		
7													
8	19		20		21		22		23		24		
9													
10	30		29		28		27		26		25		
11													
12	31		32		33		34		35		36		
13													

A. Description of original monument and accessories and/or subsequent restoration:

D-11 Set sugar quarter section post
BT's: sugar 14 S56E 40 lks ; sugar 14 N11W 40 lks
Original BT's destroyed by road construction

B. Description of corner evidence found and/or method applied in restoring or reestablishing corner:


D-11 Corner position determined from 1921 County Road Survey ties with RR spikes at Road Pl's & also ties to pipes & stakes in the Plat of Felch Mountain.

ACCEPTED BY THE DICKINSON COUNTY
SURVEY PEER GROUP AS THE OFFICIAL
CORNER UNDER MICHIGAN PUBLIC ACT
345 OF 1990 AT A MEETING HELD ON

11-12-97
ROIP
COUNTY REPRESENTATIVE

C. Description of monument for corner and accessories established to perpetuate locating the position of the corner:

D-11 Set 3/2" stamped D.C. Remon. Corner 6" below gravel in old road surface with Carsonite Stake 9'± East
NBT's: PP #86-25453 N61E 69.30; PP#86-23715 N34W 50.28; PP #86-23733 N75W 31.00;
'X' in NW corner of telephone box S12E 55.34
Note: all measurements to nail in side of poles. Bearings are Magnetic.

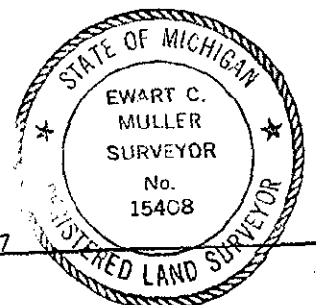

Signed by Ewart C Muller
Surveyor's Michigan License No. 15408

Date November 4, 1997