

SURVEY & REMONUMENTATION

DEC 18 1995

RECORDED

COMMISSION

LAND CORNER RECORDATION CERTIFICATE

NOV 21 AM 11:27


Filing Requirement of Act 74, Mich. P.A. 1970

For corners in Dickinson
(County)

Located In:

Corner Code #

- | | | |
|---------------------------------------|---------------------------|-------|
| 1. Public Land Survey | T <u>42N</u> R <u>28W</u> | I-11 |
| | T _____ R _____ | I-12 |
| | T _____ R _____ | _____ |
| | T _____ R _____ | _____ |
| 2. Property Controlling in Section | S _____ T _____ R _____ | _____ |
| | S _____ T _____ R _____ | _____ |
| 3. Miscellaneous Property in Section | S _____ T _____ R _____ | _____ |
| | S _____ T _____ R _____ | _____ |
| 4. Lot No. _____, Recorded Plat _____ | | |
| 5. Private Claims _____ | | |

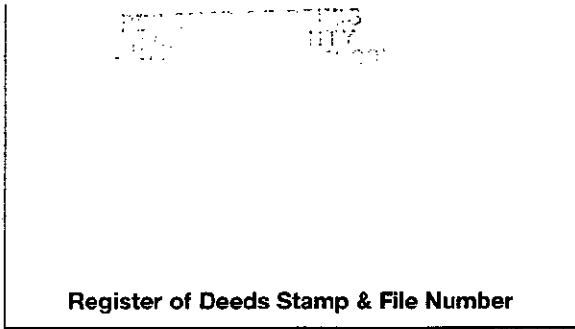

I, Robert F. Perkins, in a field survey on Mar. 17, 1995, do hereby certify that under requirements of P.A. 74, Michigan P.A. of 1970, the corner points mentioned in lines 1 and 2 above were in conformance with regulations and rules therefore as required in the current manual of survey instructions of the United States Department of the Interior, Bureau of Land Management or by a decree of a Court of Law and/or that the corner points mentioned in lines 3, 4 and 5 above were in conformance with the rules of the Michigan Board of Professional Surveyors or by a Decree of a Court of Law; established, re-established, monumented, re-monumented, recovered, found as expressed below:

A	B	C	D	E	F	G	H	I	J	K	L	M
2	6	5	4	3	2	1						
3												
4	7	8	9	10	11	12						
5												
6	18	17	16	15	14	13						
7												
8	19	20	21	22	23	24						
9												
10	30	29	28	27	26	25						
11												
12	31	32	33	34	35	36						
13												

NOTE: Not more than 4 corners, all in the same town and range, may be recorded on this certificate.

A. Description of original monument and accessories and/or subsequent restoration:

- | | |
|--|--|
| I-11 Northeast Corner, Section 34
Post John Burt, D.S. 1850
Original Bearing Trees
Sugar 12" S35°W 43 Lks.
Sugar 14" N34°E 37 Lks. | I-12 East 1/4 Corner, Section 34
Post John Burt, D.S. 1850
Original Bearing Trees
Cedar 6" S62°E 17 Lks.
Spruce 6" N60°W 17 Lks. |
|--|--|

B. Description of corner evidence found and/or method applied in restoring or reestablishing corner:

- | | |
|--|--|
| I-11 No Evidence of Original Corner or Accessories Found.
Found 1 1/2" Capped Iron Pipe at Ancient Fence Corner set by J.A. Sellick, C.E., Michigan State Highway Dept. 1937.

Corner Recorded previously on Certificate No. 630. | I-12 No Evidence of Original Corner or Accessories Found.
Corner Re-Established by Single Proportionate Measure from Corners 2657.88' North and 2657.88' South. |
|--|--|

ACCEPTED BY THE DICKINSON COUNTY SURVEY PEER GROUP AS THE OFFICIAL CORNER UNDER MICHIGAN PUBLIC ACT 345 OF 1990 AT A MEETING HELD ON 11-20-95
RFP
COUNTY REPRESENTATIVE

C. Description of monument for corner and accessories established to perpetuate locating the position of the corner:

- | | |
|---|--|
| I-11 Accepted above Found Pipe Monument.
New Witnesses
S. Maple 8" N44°E (M.B.) 17.27'
S. Maple 7" N45°W (M.B.) 15.96'
S. Maple 8" S17°W (M.B.) 17.19'
S. Maple 3" N80°E (M.B.) 24.75'
Set Carsonite Marker ±1' East. | I-12 Set 2 1/2" Stamped Dickinson County Remonumentation Monument.
New Witnesses
Balsam 6" N50°W (M.B.) 6.0'
Balsam 6" S26°W (M.B.) 17.30'
B Spruce 7" N35°E (M.B.) 10.73'
Maple 10" N70°W (M.B.) 26.75'
Set Carsonite Marker 1' West. |
|---|--|

Signed by Robert F. Perkins

Date Nov. 7, 1995

Surveyor's Michigan License No. 12027

FORM APPROVED BY MICHIGAN STATE BOARD OF PROFESSIONAL SURVEYORS, JAN. 28, 1974



192