

**SURVEY &
REMONUMENTATION**

DEC 18 1995

COMMISSION

LAND CORNER RECORDATION CERTIFICATE
Filing Requirement of Act 74, Mich. P.A. 1970

RECORDED

1995 NOV -7 AM 9:23

For corners in

<u>Dickinson</u> (County)	Located In:	Corner Code #
1. Public Land Survey	T <u>L2N</u> R <u>28W</u>	<u>J-11</u>
	T _____ R _____	_____
	T _____ R _____	_____
	T _____ R _____	_____
2. Property Controlling in Section	S _____ T _____ R _____	_____
	S _____ T _____ R _____	_____
3. Miscellaneous Property in Sec.	S _____ T _____ R _____	_____
	S _____ T _____ R _____	_____

REGISTER OF DEEDS
DICKINSON COUNTY
TOLSON, MI 49783

Register of Deeds Stamp & File Number

4. Lot No. _____, Recorded Plat _____
5. Private Claims _____

I, Edward Kazianka, in a field survey on July 7, 1995, do hereby certify that under requirements of P.A. 74, Michigan P.A. of 1970, the corner points mentioned in lines 1 and 2 above were in conformance with regulations and rules therefore as required in the current manual of survey instructions of the United States Department of the Interior, Bureau of Land Management or by a decree of a Court of Law and/or that the corner points mentioned in lines 3, 4 and 5 above were in conformance with the rules of the Michigan Board of Land Surveyors or by a Decree of a Court of Law; established, re-established, monumented, re-monumented, recovered, found as expressed below:

NOTE: Not more than 4 corners, all in the same town and range, may be recorded on this certificate.

A. Description of original monument and accessories and/or subsequent restoration:
J-11 Wood Post Sugar 10 S55E 25 lks. Cedar 10 N55W 28 lks.

1" Iron pin set by persons unknown.

B. Description of corner evidence found and/or method applied in restoring or reestablishing corner:


J-11 Found 1" iron pin in old stone fence-line. Pin is about 197 feet west of the center of the county road. Deed recorded in Vol 107, Page 244 in the office of the Register of Deeds describes the centerline traverse for the county road easement. The P.O.B. for this easement is 196 feet east of this Quarter Corner. Accepted the pin as marking the point of the original corner.

ACCEPTED BY THE DICKINSON COUNTY
SURVEY PEER GROUP AS THE OFFICIAL
CORNER UNDER MICHIGAN PUBLIC ACT
345 OF 1990 AT A MEETING HELD ON
11-6-95

RJP
COUNTY REPRESENTATIVE

C. Description of monument for corner and accessories established to perpetuate locating the position of the corner:

J-11 Replaced iron pin with a Dickinson County Survey cap/rod.
Maple 18 N79W 72.55 feet. Lynn 11 S85E 13.10 feet.
" 12 N42W 123.70 " " 5 N44E 80.10 "

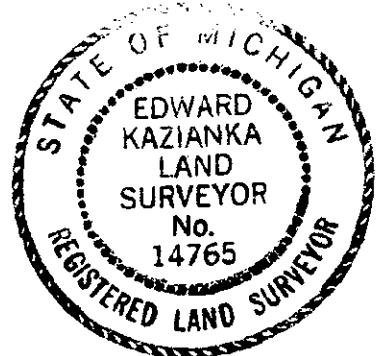

Signed by Edward Kazianka Date August 25, 1995
Surveyor's Michigan License No. 14765

1128