

To Replace Former Record 9/25/61

B.D.B.  
1/31/63

CONS. 4047  
REV. 10/60

MICHIGAN  
DEPARTMENT OF CONSERVATION  
FORESTRY DIVISION

LAND CORNER RECORD

T. 42 N. R. 28W


Dickinson COUNTY

DESCRIPTION OF CORNER North 1/8 corner between Sections 25-26

CORNER MONUMENT 1" pipe with 4" aluminum cap

DATE MONUMENT PLACED AND WITNESSED 4/23/62

WITNESSES TO CORNER..... 8" W. Spruce (BT) N70°E 23 links

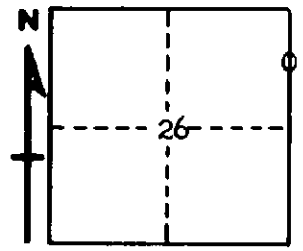

7" W. Spruce (BT) S41°E 18 links

AND

CIRCLE CORNER REGISTERED

DESCRIPTION IN DETAIL AS TO HOW CORNER WAS LOCATED AND IDENTIFIED OR RESTORED.

This corner was placed midway between Section Corner to North and 1/4 corner to south.

SURVEYOR'S SEAL

SIGNED Billy D. Buckler DATE December 12, 1962  
REGISTERED LAND SURVEYOR  
Billy D. Buckler