

MICHIGAN  
DEPARTMENT OF CONSERVATION  
FORESTRY DIVISION

# LAND CORNER RECORD

T. 42N N.R. 28W


Dickinson COUNTY

DESCRIPTION OF CORNER Center of Section 26

CORNER MONUMENT 1" iron pipe with 4" brass cap.

DATE MONUMENT PLACED AND WITNESSED 6/1/62

WITNESSES TO CORNER..... 6" Cedar (BT) (C.S.26) S27°W, 38 links

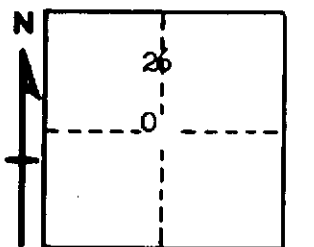

5" Black Spruce (BT)(C.S.26) N43°E, 19½ links

AND

CIRCLE CORNER REGISTERED

DESCRIPTION IN DETAIL AS TO HOW CORNER WAS LOCATED AND IDENTIFIED OR RESTORED.

This corner was placed at intersection of E&W, N-S 1/4 lines.

SURVEYOR'S SEAL

SIGNED Billy D. Buckler DATE January 23, 1963  
REGISTERED LAND SURVEYOR  
Billy D. Buckler