

MICHIGAN
DEPARTMENT OF CONSERVATION
FORESTRY DIVISION

LAND CORNER RECORD

T. 42 N.R. 28W


Dickinson COUNTY

DESCRIPTION OF CORNER 1/4 corner for sections 25-26

CORNER MONUMENT 1" pipe with 4" brass cap.

DATE MONUMENT PLACED AND WITNESSED 9-25-61

WITNESSES TO CORNER..... 7" cedar (1/2 S NBT) S 42°W 54 links

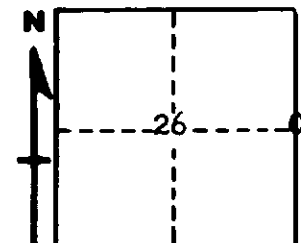

6" " " " S 72°E 79 1/2 links

Corner lies on west edge of road.

AND

CIRCLE CORNER REGISTERED

DESCRIPTION IN DETAIL AS TO HOW CORNER WAS LOCATED AND IDENTIFIED OR RESTORED.

This corner was re-established midway and on line between two section corners. Found no evidence of original corner. Area has been cleared for road building.

SURVEYOR'S SEAL

SIGNED Billy D. Buckler DATE March 13, 1962
REGISTERED LAND SURVEYOR
Billy D. Buckler