

MICHIGAN
DEPARTMENT OF CONSERVATION
FORESTRY DIVISION

LAND CORNER RECORD

T. 42. NR. 28. W. . .

Dickinson

COUNTY

DESCRIPTION OF CORNER 1/4 Section Corner between Sections 16, 17.

DESCRIPTION OF CORNER MONUMENT 1" pipe with 4" brass cap.

WITNESSES TO CORNER 10" Cedar N 58° W 45 links

9" Cedar S 45° W 29 links


DESCRIPTION IN DETAIL AS TO HOW CORNER WAS LOCATED AND IDENTIFIED OR RESTORED.

Replaced 1/4 Section Corner between 16-17, from original B.T.

One Cedar B.T. in place, poor condition.

This 1/4 Corner shown to us by H. S. Peterson, District Forester.

Corner placed and witnessed July 18, 1955.

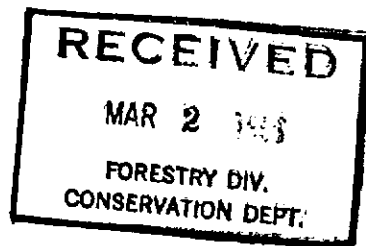

SURVEYORS SEAL

SIGNED Billy D. Buckles DATE 2/27/56
REGISTERED LAND SURVEYOR