

MICHIGAN
DEPARTMENT OF CONSERVATION
FORESTRY DIVISION

LAND CORNER RECORD

T. 42N R. 28W

Dickinson COUNTY


DESCRIPTION OF CORNER Sec. Cor. for Secs. 14-15-22-23

CORNER MONUMENT 1" iron pipe with 4" aluminum cap.

DATE MONUMENT PLACED AND WITNESSED 8/24/66

WITNESSES TO CORNER..... 12" Elm (S14)(NBT) N71°E, 12½ lks.

10" Elm (S22)(NBT) S75°W, 37 lks.

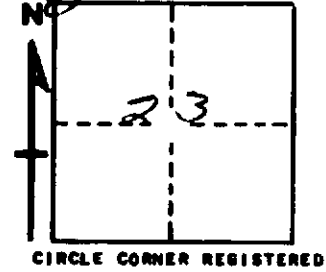

AND _____

DESCRIPTION IN DETAIL AS TO HOW CORNER WAS LOCATED AND IDENTIFIED OR RESTORED.

This corner was re-established by double proportioned measurement bet. sec. cors. 1 mile to north, south and west and 2 miles to east.

SURVEYOR'S SEAL

SIGNED *R. J. Bray* DATE 1/11/67
R. J. Bray
REGISTERED LAND SURVEYOR