

MICHIGAN  
DEPARTMENT OF CONSERVATION  
FORESTRY DIVISION



# LAND CORNER RECORD

T. 42N N.R. 28W


Dickinson COUNTY

DESCRIPTION OF CORNER 1/2 cor. for Secs. 15-22

CORNER MONUMENT 1" iron pipe with 4" aluminum cap.

DATE MONUMENT PLACED AND WITNESSED 8/26/66

WITNESSES TO CORNER..... 12" H. Maple (1/2S)(NBT) N66°E, 16 lks.

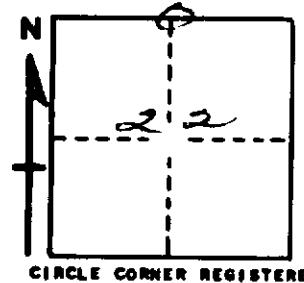

10" H. Maple (1/2S)(NBT) S89°W, 10 lks.

AND

DESCRIPTION IN DETAIL AS TO HOW CORNER WAS LOCATED AND IDENTIFIED OR RESTORED.

This corner was placed midway and on line bet. sec. cors. 1/2 mile to east and to west. No original evidence found.

SURVEYOR'S SEAL

SIGNED *F. J. Bray*  
F. J. Bray  
REGISTERED LAND SURVEYOR

DATE 1/13/67