

LAND CORNER RECORDATION CERTIFICATE
Filing Requirement of Act 74, Mich. P.A. 1970

For corners in
Dickinson

(County)

Located In:

Corner Code #

1. Public Land Survey	T <u>42N</u> R <u>28W</u>	<u>D6</u>
	T <u> </u> R <u> </u>	<u> </u>
	T <u> </u> R <u> </u>	<u> </u>
	T <u> </u> R <u> </u>	<u> </u>
2. Property Controlling in Section	S <u>20</u> T <u>42N</u> R <u>28W</u>	<u>1</u>
	S <u> </u> T <u> </u> R <u> </u>	<u> </u>
3. Miscellaneous Property in Sec.	S <u> </u> T <u> </u> R <u> </u>	<u> </u>
	S <u> </u> T <u> </u> R <u> </u>	<u> </u>

Register of Deeds Stamp & File Number

4. Lot No. _____, Recorded Plat _____
 5. Private Claims _____

D6 Apr 19 2005
 1 Mar 02 2005

I, Stephan J. Szyszkoski, in a field survey on _____, 19____ do hereby state that under requirements of P.A. 74, Michigan P.A. of 1970, the corner points mentioned in lines 1 and 2 above were in conformance with regulations and rules therefore as required in the current manual of survey instructions of the United States Department of the Interior, Bureau of Land Management or by a decree of a Court of Law and/or that the corner points mentioned in lines 3, 4 and 5 above were in conformance with the rules of the Michigan Board of Land Surveyors or by a Decree of a Court of Law, established, re-established, monumented, recovered, found as expressed below:

NOTE: Not more than 2 corners, all in the same town and range, may be recorded on this certificate.

A	B	C	D	E	F	G	H	I	J	K	L	M
1												
2	6		5		4		3		2		1	
3												
4	7		8		9		10		11		12	
5												
6	18		15		16		15		14		13	
7												
8	19		20		21		22		23		24	
9												
10	30		29		28		27		26		25	
11												
12	31		32		33		34		35		36	
13												

A. Description of original monument and accessories and/or subsequent restoration:


(D6) Center of Section 17. Not established in the original survey.
 (1-Sec. 20) West 1/16 corner between Sections 17 and 20. Established by Frank J. Bray in 1966 midway and on line between Section and Quarter corners. Set 1" iron pipe with 4" aluminum cap. 5" Cedar N39E 49.5 links, 10" Cedar S74E 65 links.

B. Description of corner evidence found and/or method applied in restoring or reestablishing corner:

(D6) Established the corner at the intersection of straight lines connecting opposite 1/4 corners. The corner position falls on a steep, broken, rocky face. The monument was driven to refusal and was made firm in a mound of rock 3.5' long x 4' wide.
 (1-Sec. 20) The 1966 monument was found disturbed. Only one of the 1966 BTs remains. Reestablished the corner midway and on the section line between corners C7 and D7, 1320.94' west and east. From the position thus established, the remaining 1966 N8T Cedar, now 12" S69E 44.6', checks fairly well with the record.

C. Description of monument for corner and accessories established to perpetuate locating the position of the corner:

(D6) Set 1"IDx36" I.pipe with 4" alum. MDNR cap. Set measuring nails in: 3" Spruce N72E 3.7' mrkd "C1/4 BT" 15" Cedar S08E 45.0' do 11" Cedar S88W 37.8' do 9" Cedar N76W 35.7' do Set sq'd cedar post adjacent. Bearings are magnetic. Distances are to nail with tag.	(1) Set 1"IDx32" I.pipe with 4" alum. MDNR cap. Set measuring nails in: 10" Cedar S74W 59.0' mrkd "1/16S BT" 8" Cedar N21W 48.6' do 10" Tamarack N29E 35.7' do 12" Cedar S69E 44.6' overgrown blazes * Set sq'd cedar post adjacent. Bearings are magnetic. Distances are to nail with tag. * denotes 1966 BT.
--	---

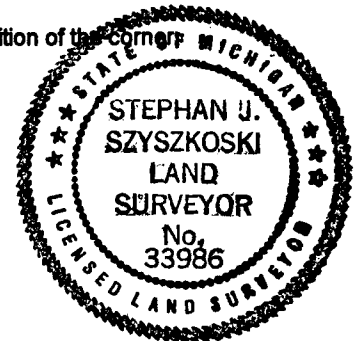

Signed by Stephan J. Szyszkoski Date 7/20/05
 Surveyor's Michigan License No. 33986