

LAND CORNER RECORDATION CERTIFICATE
 Filing Requirement of Act 74, Mich. P.A. 1970 as Amended

ir corners in

<u>Dickinson</u> (County)	Located In:	Corner Code #
ELCH TOWNSHIP Public Land Survey	T 42N R 29W T 42N R 29W T _____ R _____	E08 G08 _____
Property Controlling Section	S _____ T _____ R _____ S _____ T _____ R _____ S _____ T _____ R _____	_____
Miscellaneous Property in Sec.	S _____ T _____ R _____ S _____ T _____ R _____	_____

Lot No. _____, Recorded Plat _____
 Private Claims _____

Jeremy J. Pipp, in a field survey on 6/25/2014 do hereby state
 that under requirements of P.A. 74, Michigan P.A. of 1970, the corner points mentioned in lines 1 and 2
 above were in conformance with regulations and rules therefore as required in the current manual of survey
 instructions of the United States Department of the Interior, Bureau of Land Management or by a decree of
 Court of Law and /or that the corner points mentioned in lines 3, 4 and 5 above were in conformance with
 the rules of the Michigan Board of Land Surveyors or by a Decree of a Court of Law; established,
 re-established, monumented, recovered, found as expressed below:

NOTE: Not more than 2 corners, all in the same town and range, may be recorded
 on this certificate.

1. Description of original monument and accessories and/or subsequent restoration:

E08) Quarter corner common to Sections 20 and 21. 1849: John Burt, DS. Set Cedar post witnessed
 by: Hemlock 14 N35E 27 links (17.82'), Sugar 16 S27W 65 links (42.90'). 1977: Michigan DNR
 Arthur Enger, PS#13581) Set 1" pipe with 3 3/4" capped DNR monument by proportionate method
 witnessed by Sugar Maple 14 N38-14W 28.5', Sugar Maple 6 N12-38E 16.6'.

G08) Quarter corner common to Sections 21 and 22. 1849: John Burt, DS. Set Cedar post witnessed
 by: Y. Birch 12 N45W 8 links (5.28'), Cedar 12 S49E 12 links (7.92'). 1977: Michigan DNR
 Arthur Enger, PS#13581) Set 1" pipe with 3 3/4" capped DNR monument from probable bearing tree
 witnessed by Cedar Stump 22 S76 1/2E 44.4', Cedar 16 N53 1/2E 82.2'.

2. Description of corner evidence found and/or method applied in restoring or reestablishing corner:

E08) Accepted found MDNR Monument and Two NBT Witnesses (both living). Position is accepted as a
 careful and faithful REESTABLISHMENT of the position of the original corner.


G08) Accepted found MDNR Monument and Two NBT Witnesses (both dead, poor condition). Position is
 accepted as a careful and faithful PERPETUATION of the position of the original corner.

3. Description of monument for corner and accessories established to perpetuate locating the position of the corner:

(E08) DNR monument	(G08) DNR monument
EX 10" Maple N25E 16.77' (1/4S,NBT)	5" Ash N53E 35.90' (1/4S,NBT)
10" Maple S76E 31.53' (1/4S,NBT)	10" Tamarack S69E 36.87' (1/4S,NBT)
1" Maple S76W 17.37' (1/4S,NBT)	13" Spruce S81W 20.50' (1/4S,NBT)
EX 22" Maple N26W 28.75' (1/4S,NBT)	10" Spruce N36W 25.43' (1/4S,NBT)
All trees are blazed, scribed, painted, and signed. Measurements are to nail in side of tree, bearings are magnetic. A Carsonite rail was set North 1.5 feet.	All trees are blazed, scribed, painted, and signed. Measurements are to nail in side of tree, bearings are magnetic. A Carsonite rail was set North 1.5 feet.

Signed by Jeremy J. Pipp Date July 15, 2014
 Surveyor's Michigan License No. 50447

For the Michigan Department of Natural Resources, Professional Surveyors Division

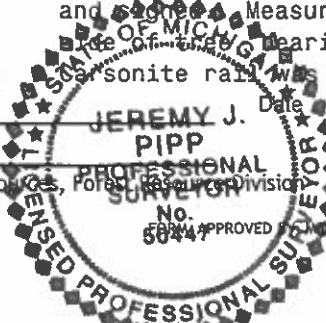

Register of Deeds Stamp & File Number

1	A	B	C	D	E	F	G	H	I	J	K	L	M
2		6		5		4		3		2		1	
3													
4		7		8		9		10		11		12	
5													
6		18		17		16		15		14		13	
7													
8		19		20		21		22		23		24	
9													
10		30		29		28		27		26		25	
11													
12		31		32		33		34		35		36	
13													