

# SURVEY & REMONUMENTATION

APR 27 1995

**COMMISSION**

## LAND CORNER RECORDATION CERTIFICATE Filing Requirement of Act 74, Mich. P.A. 1970

For corners in \_\_\_\_\_

Dickinson  
(County)

Located in:

Corner Code ##

- |                                      |                           |      |  |
|--------------------------------------|---------------------------|------|--|
| 1. Public Land Survey                | T <u>42N</u> R <u>29W</u> | K-9  |  |
|                                      | T <u>42N</u> R <u>29W</u> | K-10 |  |
|                                      | T _____ R _____           |      |  |
|                                      | T _____ R _____           |      |  |
| 2. Property Controlling in Section # | S _____ T _____ R _____   |      |  |
|                                      | S _____ T _____ R _____   |      |  |
| 3. Miscellaneous Property in Sec.    | S _____ T _____ R _____   |      |  |
|                                      | S _____ T _____ R _____   |      |  |

REGISTER OF DEEDS  
MICHIGAN COUNTY  
AND REGISTERED PROFESSIONAL

NOV 10 AM 9:41

RECORDED

Register of Deeds Stamp & File Number

4. Lot No. \_\_\_\_\_, Recorded Plat \_\_\_\_\_

5. Private Claims \_\_\_\_\_

	A	B	C	D	E	F	G	H	I	J	K	L	M
2	6	5	4	3	2	1							
3													
4	7	8	9	10	11	12							
5													
6	18	17	16	15	14	13							
7													
8	19	20	21	22	23	24							
9													
10	30	29	28	27	26	25							
11													
12	31	32	33	34	35	36							
13													

I, Ewart C. Muller in a field survey on October, 1994

do hereby certify that under requirements of P.A. 74, Michigan P.A. of 1970, the corner points mentioned in lines 1 and 2 above were in conformance with regulations and rules therefore as required in the current manual of survey instructions of the United States Department of the Interior, Bureau of Land Management or by a decree of a Court of Law and/or that the corner points mentioned in lines 3, 4 and 5 above were in conformance with the rules of the Michigan Board of Land Surveyors or by a Decree of a Court of Law; established, re-established, monumented, re-monumented, recovered, found as expressed below:

**NOTE: Not more than 4 corners, all in the same town and range, may be recorded on this certificate.**

Township Subdivided by John Burt, DS, 1849.

A. Description of original monument and accessories and/or subsequent restoration:

K-9 Set Y. Birch post corner of Sections 23, 24, 25 & 26.

BT's: Sugar 10 S69E 15 lks; Sugar 16 N56W 75 lks. (1909 and 1915 Road Surveys found post & BT's)

K-10 Quarter Section Corner between Sections 25 & 26. (1909 and 1915 Road Surveys found post & BT's)

BT: Cedar 8 S76W 15 lks.

B. Description of corner evidence found and/or method applied in restoring or reestablishing corner:

K-9 1915 Road Survey set round iron. (Found RR spike set over iron)

K-10 1915 Road Survey set round iron. (Found Rr spike set over iron)

ACCEPTED BY THE DICKINSON COUNTY  
SURVEY PEER GROUP AS THE OFFICIAL  
CORNER UNDER MICHIGAN PUBLIC ACT  
345 OF 1990 AT A MEETING HELD ON

11-7-94

RJP

COUNTY REPRESENTATIVE

C. Description of monument for corner and accessories established to perpetuate locating the position of the corner:

K-9 Set Dickinson County cap/rod in Monument Box - Carsonite Stake set at 33 foot East R/W line  
NBT's: PP# 74-3530 N52E 50.72; Aspen 8 S67E 72.70; H. Mpl 9 S67W 66.90; Aspen 10 N32W 44.25.


K-10 Set Dickinson County cap/rod in Monument Box - Carsonite Stake set at 33 foot East R/W line.  
NBT's: PP# 74-3528 S81E 33.40; Southwest corner of cabin S42E 102.23; H. Mpl 9 S61W 41.35;  
Apple 6 West 30.73.

Note: Bearings are Magnetic. Distances measured to center of pipes and 16d nails in side of trees or \_\_\_\_\_

Signed by Ewart C Muller

Date November 7, 1994

Surveyor's Michigan License No. 15408

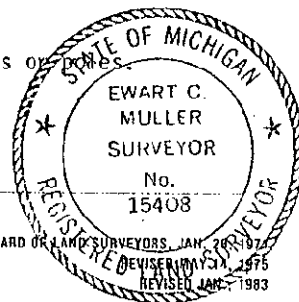

FORM APPROVED BY MICHIGAN STATE BOARD OF LAND SURVEYORS, JAN. 26, 1972  
REVISED MAY 31, 1975  
REVISED JAN. 1983

Liber 2 Page 105