

RECORDED

LAND CORNER RECORDATION CERTIFICATE

Filing Requirement of Act 74, Mich. P.A. 1970

NOV 10 AM 11:07

For corners in

Dickinson (County) Felch Twp.

Located In:

Corner Code #

- 1. Public Land Survey T 42N R 29W K-12
2. Property Controlling in Section S T R
3. Miscellaneous Property in Sec. S T R

REGISTER OF DEEDS DICKINSON COUNTY

SURVEY & RECORDED DOCUMENTATION

MAR 24 2000

Register of Deeds Stamp & File Number

- 4. Lot No. , Recorded Plat SECTION
5. Private Claims

Grid table with columns A-M and rows 2-13. A dot is present in cell J12.

I, Edward Kazianka, in a field survey on October 8, 1999, do hereby certify that under requirements of P.A. 74, Michigan P.A. of 1970, the corner points mentioned in lines 1 and 2 above were in conformance with regulations and rules therefore as required in the current manual of survey instructions of the United States Department of the Interior, Bureau of Land Management or by a decree of a Court of Law and/or that the corner points mentioned in lines 3, 4 and 5 above were in conformance with the rules of the Michigan Board of Land Surveyors or by a Decree of a Court of Law; established, re-established, monumented, re-monumented, recovered, found as expressed below:

NOTE: Not more than 4 corners, all in the same town and range, may be recorded on this certificate.

A. Description of original monument and accessories and/or subsequent restoration:

- K-12 Quarter Corner between Sections 35 and 36. Post by John Burt, D.S., in Sept. 1849 Sugar 10 S57W 35 lks. " 8 N36E 31 lks.


B. Description of corner evidence found and/or method applied in restoring or reestablishing corner:

- K-12 Found 3/4 inch by 20 inch iron rod. Rod was 2642.9 feet south of the northwest corner and 5281.5 feet west of the East Quarter corner of Section 36. Old stone and wire fence lines to the south and east. Wire fence lines to the north and west. Accepted the iron rod as being the Quarter corner.

ACCEPTED BY THE DICKINSON COUNTY SURVEY PEER GROUP AS THE OFFICIAL CORNER UNDER MICHIGAN PUBLIC ACT 345 OF 1990 AT A MEETING HELD ON 11-9-99

C. Description of monument for corner and accessories established to perpetuate locating the position of the corner:

- K-12 Set 2 1/2 inch Stamped D.C. Remon. corner in place of iron rod. P. Pole # 86-23577 N25W 52.46 feet. Maple 26 S 08W 18.40 feet. P. " # 86-23578 N83E 239.10 feet. " 24 S 02E 37.00 feet. Carsonite Marker S45W 2.0 feet.

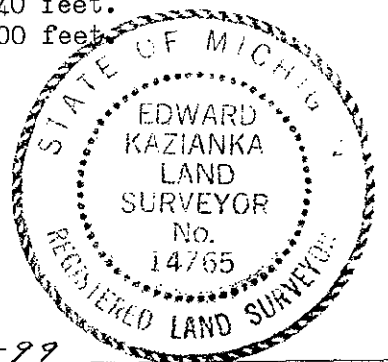

Signed by Edward Kazianka

Date 11-10-99

Surveyor's Michigan License No. 14765