

Reamon M-12 42-29 ✓

RECORDED

1999 JAN 28 AM 8:52

LAND CORNER RECORDATION CERTIFICATE
Filing Requirement of Act 74, Mich. P.A. 1970

For corners in

<u>Dickinson</u>	Located In:	Corner Code #
(County)		
<u>Felch Twp.</u>		
1. Public Land Survey	<u>T 42N R 28W</u>	<u>A-12</u>
	T ___ R ___	___
	T ___ R ___	___
	T ___ R ___	___
2. Property Controlling in Section	S ___ T ___ R ___	___
	S ___ T ___ R ___	___
3. Miscellaneous Property in Sec.	S ___ T ___ R ___	___
	S ___ T ___ R ___	___

REGISTER OF DEEDS
DICKINSON COUNTY
ROM 12-7-98

Register of Deeds Stamp & File Number

4. Lot No. _____, Recorded Plat _____ SECTION _____
5. Private Claims _____

I, Robert F. Perkins, in a field survey on June 16, 1998 do hereby state that under requirements of P.A. 74, Michigan P.A. of 1970, the corner points mentioned in lines 1 and 2 above were in conformance with regulations and rules therefore as required in the current manual of survey instructions of the United States Department of the Interior, Bureau of Land Management or by a decree of a Court of Law and /or that the corner points mentioned in lines 3, 4 and 5 above were in conformance with the rules of the Michigan Board of Land Surveyors or by a Decree of a Court of Law; established, re-established, monumented, recovered, found as expressed below:

A	B	C	D	E	F	G	H	I	J	K	L	M
1												
2	6		5		4		3		2		1	
3												
4	7		8		9		10		11		12	
5												
6	18		17		16		15		14		13	
7												
8	19		20		21		22		23		24	
9												
10	30		29		28		27		26		25	
11												
12	31		32		33		34		35		36	
13												

NOTE: Not more than 2 corners, all in the same town and range, may be recorded on this certificate.

A. Description of original monument and accessories and/or subsequent restoration:

A-12 West 1/4 Corner Section 31
Post by William A. Burt, D.S. 1846
Original Bearing Trees
Sugar 20" N21°E 20 Lk.
Sugar 16" S62 1/2°W 51 Lk.


ACCEPTED BY THE DICKINSON COUNTY
SURVEY PEER GROUP AS THE OFFICIAL
CORNER UNDER MICHIGAN PUBLIC ACT
345 OF 1990 AT A MEETING HELD ON
12-7-98
RFP
COUNTY REPRESENTATIVE

B. Description of corner evidence found and/or method applied in restoring or reestablishing corner:

A-12 No Evidence of Original Corner
or its Accessories Found.
Found 5/8" x 24" Iron Pin buried in Road Centerline at Ancient Fence Line
West and 2635.32' South of Section Corner to North. Location agrees with
old Dickinson County Road Commission Data.

C. Description of monument for corner and accessories established to perpetuate locating the position of the corner:

A-12 Accepted Pin described in "B" above as Best Remaining Evidence of Corner
Location and Replaced same with 2 1/2" Stamped D.C. Remon. Corner.
Also Set 3 1/2" D.C. Remon. Witness Corner 20.00' West.
New Witnesses:
P.Pole #86-23599 N9°W(M.B.) 52.95' Nail/Tag
P.Pole #86-23600 N85°E(M.B.) 186.02' Nail/Tag
Spruce 6" S47°W(M.B.) 30.82' Nail/Tag
Placed Carsonite Marker at Witness Corner.

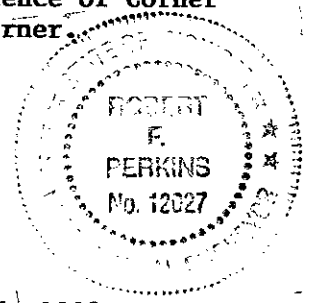

Signed by Robert F. Perkins
Surveyor's Michigan License No. 12027

Date Nov. 6, 1998