

LAND CORNER RECORDATION CERTIFICATE
Filing Requirement of Act 74, Mich. P.A. 1970 as Amended

For corners in

<u>Dickinson</u> (County)	Located In:	Corner Code #
1. Public Land Survey	T _____ R _____	_____
	T _____ R _____	_____
	T _____ R _____	_____
2. Property Controlling in Section	S _____ T _____ R _____	_____
	S 25 T 42N R 29W	6
	S 25 T 42N R 29W	9
3. Miscellaneous Property in Sec.	S _____ T _____ R _____	_____
	S _____ T _____ R _____	_____

4. Lot No. _____, Recorded Plat _____
 5. Private Claims _____

Aug 11 2004

I, Stephan J. Szyszkoski, in a field survey on _____, 20____ do hereby state that under requirements of P.A. 74, Michigan P.A. of 1970, the corner points mentioned in lines 1 and 2 above were in conformance with regulations and rules therefore as required in the current manual of survey instructions of the United States Department of the Interior, Bureau of Land Management or by a decree of a Court of Law and /or that the corner points mentioned in lines 3, 4 and 5 above were in conformance with the rules of the Michigan Board of Land Surveyors or by a Decree of a Court of Law; established, re-established, monumented, recovered, found as expressed below:

NOTE: Not more than 2 corners, all in the same town and range, may be recorded on this certificate.

A. Description of original monument and accessories and/or subsequent restoration:

- (6-Sec. 25) Northeast 1/16 corner. Not established in the original survey.
- (9-Sec. 25) East 1/16 corner, Section 25. Not established in the original survey.

B. Description of corner evidence found and/or method applied in restoring or reestablishing corner:


- (6-Sec. 25) Established the corner at the intersection of straight lines connecting opposite 1/16 corners. The E1/16 corner between Sections 24 and 25 and the North 1/16 corner on the East line of Section 25 are unmonumented.
- (9-Sec. 25) Established the corner midway and on a straight line between Center of Section 1322.47' west and Quarter corner 1322.47' east.

C. Description of monument for corner and accessories established to perpetuate locating the position of the corner:

- | | |
|---|--|
| (6) Set 1"IDx32" I.pipe with 4" alum.
MDNR cap. Blazed, scribed, and set
measuring nails in:
11" Spruce S05W 17.3' "1/16S BT"
10" Maple S30E 56.3' do
8" Balsam S69E 6.4' do
9" Maple S26W 45.7' do
Set sq'd cedar post adjacent. Bearings
are magnetic. Distances are to nail
with tag. | (9) Set 1"IDx32" I.pipe with 4" alum.
MDNR cap. Blazed, scribed, and set
measuring nails in:
9" Tamarack N03E 6.8' "1/16S BT"
12" Tamarack N78E 27.0' do
6" Balsam S01W 15.6' do
8" Poplar N80W 15.3' do
Set squared tamarack post adjacent.
Bearings are magnetic. Distances are to
nail with tag. |
|---|--|

Register of Deeds Stamp & File Number

1	A	B	C	D	E	F	G	H	I	J	K	L	M
2		6		5		4		3		2		1	
3													
4		7		8		9		10		11		12	
5													
6		18		17		16		15		14		13	
7													
8		19		20		21		22		23		24	
9													
10		30		29		28		27		26		25	
11													
12		31		32		33		34		35		36	
13													

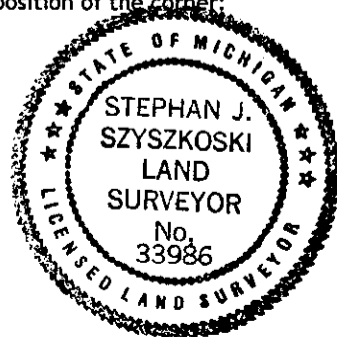

Signed by Stephan J. Szyszkoski
 Surveyor's Michigan License No. 33986

Date 8/17/04