LAND CORNER RECORDATION CERTIFICATE
Filing Requirement of Act 74, Mich. P.A. 1970 as Amended

For corners in

Dickinson
(County)

		Located In:		Corner Code #
1. Public Land Survey		T 42N	R 29W	L10
		T	R	
		T	R	
	S	T	R	
2. Property Controlling	S 25	T 42N	R 29W	5
in Section	S	T	R	
3. Miscellaneous	S	T	R	
Property in Sec.	S	T	R	

Register of Deeds Stamp & File Number

4. Lot No. _____ , Recorded Plat_____
5. Private Claims

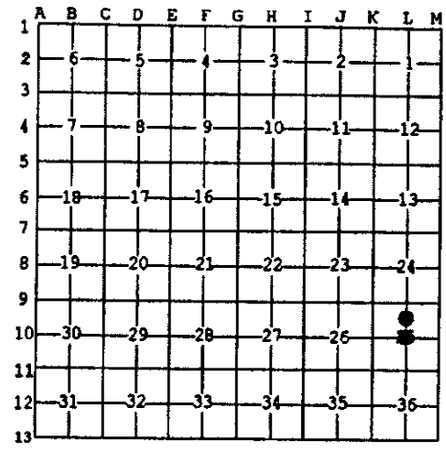

I, Stephan J. Szyszkoski, in a field survey on Aug 11 2004, 20 ____ do hereby state that under requirements of P.A. 74, Michigan P.A. of 1970, the corner points mentioned in lines 1 and 2 above were in conformance with regulations and rules therefore as required in the current manual of survey instructions of the United States Department of the Interior, Bureau of Land Management or by a decree of a Court of Law and /or that the corner points mentioned in lines 3, 4 and 5 above were in conformance with the rules of the Michigan Board of Land Surveyors or by a Decree of a Court of Law; established, re-established, monumented, recovered, found as expressed below:

NOTE: Not more than 2 corners, all in the same town and range, may be recorded on this certificate.

A. Description of original monument and accessories and/or subsequent restoration:

(L10) Center of Section 25. Not established in the original survey. Previously established in 2001 by R.F.Perkins, PS 12027.
(5-Sec. 25) North 1/16 corner, Section 25. Not established in the original survey. Previously established by R.F.Perkins, PS 12027, date unknown.

B. Description of corner evidence found and/or method applied in restoring or reestablishing corner:

(L10) Found a 3/4" aluminum rod with 2.5" dia. aluminum cap stamped "T42N R29W C1/4 Sec 25 PS 12027 2001 SURVEY" at the intersection of straight lines connecting opposite Quarter corners. Accepted same as a careful and faithful determination of the position of the corner. Left the monument in place and made witnesses as described below.
(5-Sec. 25) Found a 5/8" rebar with plastic cap "R.F.Perkins PS 12027" midway and on line between Quarter corner to north and Center of Section to south. Accepted same as a careful and faithful determination of the position of the corner.

C. Description of monument for corner and accessories established to perpetuate locating the position of the corner:

(L10) Fd. 3/4" alum. rod with 2.5" dia alum. cap. Fd. measuring nails in the following blazed and painted trees:
8" B.Ash S62W 46.25'
6" Balsam N44W 52.35'
5" Balsam N68E 26.50'
8" B.Ash S75E 33.40'
A cedar post is adjacent. Bearings are magnetic. Distances are to found nail in the side of the tree.

(5) Found 5/8" capped rebar. Blazed, scribed, and set measuring nails in:

4" Balsam N04W 14.3'	"1/16S BT"
8" Cedar N65E 52.0'	do
6" Spruce S10W 22.4'	do
13" Cedar S77W 22.3'	do

Set cedar post adjacent. Bearings are magnetic. Distances are to nail with tag.

STATE OF MICHIGAN
STEPHAN J. SZYSZKOSKI
LAND SURVEYOR
No. 33986
LICENSED LAND SURVEYOR

Signed by Stephan J. Szyszkoski Date 8/17/04

Surveyor's Michigan License No. 33986

For the Michigan Department of Natural Resources, Office of Land and Facilities

FORM APPROVED BY MICHIGAN STATE BOARD OF PROFESSIONAL SURVEYORS, JAN. 28, 1971
Revised May 14, 1975
Revised Jan., 1983
Rervised Oct., 1995