

A-13/A-1 T 41 N R 30 W **LAND CORNER RECORDATION CERTIFICATE**
 Filing Requirement of Act 74, Mich. P.A. 1970

RECORDED

1999 NOV 30 PM 3:23

For corners in

DICKINSON Located In: _____ Corner Code # _____
 (County)

SAGOLA TOWNSHIP

1. Public Land Survey T 42 N R 30 W A-13
T 42 N R 30 W A-13
 T _____ R _____
 T _____ R _____
 2. Property Controlling S _____ T _____ R _____
 in Section S _____ T _____ R _____
 3. Miscellaneous S _____ T _____ R _____
 Property in Sec. S _____ T _____ R _____

REGISTER OF DEEDS
 CLERK

Register of Deeds Stamp & File Number

4. Lot No. _____, Recorded Plat _____ SECTION _____

5. Private Claims _____

I, JAMES H. MOORE, in a field survey on AUGUST 17, 19 99 do hereby state that under requirements of P.A. 74, Michigan P.A. of 1970, the corner points mentioned in lines 1 and 2 above were in conformance with regulations and rules therefore as required in the current manual of survey instructions of the United States Department of the Interior, Bureau of Land Management or by a decree of a Court of Law and /or that the corner points mentioned in lines 3, 4 and 5 above were in conformance with the rules of the Michigan Board of Land Surveyors or by a Decree of a Court of Law; established, reestablished, monumented, recovered, found as expressed below:

	A	B	C	D	E	F	G	H	I	J	K	L	M
1													
2	6			5			4		3		2		1
3													
4	7			8			9		10		11		12
5													
6	18			17			16		15		14		13
7													
8	19			20			21		22		23		24
9													
10	30			29			28		27		26		25
11													
12	31			32			33		34		35		36
13													

NOTE: Not more than 2 corners, all in the same town and range, may be recorded on this certificate.

A. Description of original monument and accessories and/or subsequent restoration:

A-13 CORNER COMMON TO TOWNSHIPS 41 AND 42 NORTH, A-11 CORNER COMMON TO SECTIONS 30-31 (T42N-R30W) AND SECTIONS 25-26 (T42N-R31W)
 POST BY WILLIAM BURT, D.S. 1846
 CEDAR 18" S75°E 15 LINKS
 YELLOW BIRCH 12" N73°W 21 LINKS
 SPRUCE POST BY WILLIAM BURT, D.S. 1846
 YELLOW BIRCH 10" S 72° W 34 LINKS
 YELLOW BIRCH 14" N 22° W 27 LINKS


B. Description of corner evidence found and/or method applied in restoring or reestablishing corner:

A-13 FOUND KIMBERLY-CLARKE CORP. 4" ALUMINUM CAP, A-11 FOUND KIMBERLY-CLARKE CORP. 4" ALUMINUM CAP
 SPERHAKE, RLS 7876, DATE STAMPED 5-5-60. SPERHAKE, RLS 7876, DATE STAMPED 5-23-60.
 1960 BEARING TREES
 MAPLE 5" N50°E 46 LINKS
 BASSWOOD 7" N44°W 71 LINKS
 HEMLOCK 16" S71°W 71 LINKS
 SPRUCE 9" S46°E 70 LINKS
 1960 BEARING TREES
 WHITE PINE 17" N39°E 142 LINKS
 SPRUCE 12" N18°W 100 LINKS
 POPLAR 4" S31°W 87 LINKS
 POPLAR 3" S50°E 35 LINKS

C. Description of monument for corner and accessories established to perpetuate locating the position of the corner:

A-13 FOUND ABOVE DESCRIBED MONUMENT IN PLACE A-11 FOUND ABOVE DESCRIBED MONUMENT IN PLACE
 NEW WITNESSES NEW WITNESSES
 7" MAPLE S48° W (M.B.) 9.59' NAIL/TAG
 5" ASH S30° E (M.B.) 19.90' NAIL/TAG
 7" MAPLE N33° E (M.B.) 15.23' NAIL/TAG
 7" MAPLE N 30° W (M.B.) 19.30' NAIL/TAG
 CARSONITE MARKER NORTH 1.44'
 FOUND 10" POPLAR STUMP S 35° W (M.B.) 57.42' (DEAD)
 FOUND 14" SPRUCE N14°W (M.B.) 65.71' NAIL/TAG
 10" RED PINE S74°W (M.B.) 53.94' NAIL/TAG
 14" POPLAR S31°W (M.B.) 59.21' NAIL/TAG
 12" SPRUCE EAST (M.B.) 5.64' NAIL/TAG
 CARSONITE MARKER NORTH 1.3'

Signed by _____ Date 11-8-99
 Surveyor's Michigan License No. 28423

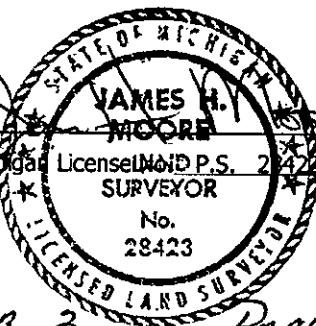

ACCEPTED BY THE DICKINSON COUNTY SURVEY PEER GROUP AS THE OFFICIAL OWNER UNDER MICHIGAN PUBLIC ACT 346 OF 1990 AT A MEETING HELD ON 11-23-99

REVISED MAY 14, 1975
 REVISED JAN., 1983
 REVISED OCT., 1995

Liber 3 PAGE 20

COUNTY REPRESENTATIVE