

LAND CORNER RECORDATION CERTIFICATE
Filing Requirement of Act 74, Mich. P.A. 1970

RECORDED

1999 NOV 30 PM 3:23

For corners in

DICKINSON
 (County)
SAGOLA TOWNSHIP

Located In: _____ Corner Code # _____

- | | | |
|------------------------------------|-----------------------------|-------------|
| 1. Public Land Survey | T <u>42</u> N R <u>30</u> W | <u>B-11</u> |
| | T <u>42</u> N R <u>30</u> W | <u>C-11</u> |
| | T _____ R _____ | _____ |
| | T _____ R _____ | _____ |
| 2. Property Controlling in Section | S _____ T _____ R _____ | _____ |
| | S _____ T _____ R _____ | _____ |
| 3. Miscellaneous Property in Sec. | S _____ T _____ R _____ | _____ |
| | S _____ T _____ R _____ | _____ |

REGISTRATION DIVISION
 DIVISION OF LAND RECORDS
 3000 FERRY ST.

Register of Deeds Stamp & File Number

MAR 24 2000

4. Lot No. _____, Recorded Plat _____ SECTION _____

5. Private Claims _____

I, JAMES H. MOORE, in a field survey on SEPTEMBER 30 & OCTOBER 13, 19 99 do hereby state that under requirements of P.A. 74, Michigan P.A. of 1970, the corner points mentioned in lines 1 and 2 above were in conformance with regulations and rules therefore as required in the current manual of survey instructions of the United States Department of the Interior, Bureau of Land Management or by a decree of a Court of Law and /or that the corner points mentioned in lines 3, 4 and 5 above were in conformance with the rules of the Michigan Board of Land Surveyors or by a Decree of a Court of Law; established, re-established, monumented, recovered, found as expressed below:

NOTE: Not more than 2 corners, all in the same town and range, may be recorded on this certificate.

	A	B	C	D	E	F	G	H	I	J	K	L	M
1													
2	6		5		4		3		2		1		
3													
4	7		8		9		10		11		12		
5													
6	18		17		16		15		14		13		
7													
8	19		20		21		22		23		24		
9													
10	30		29		28		27		26		25		
11	●	●											
12	31		32		33		34		35		36		
13													

A. Description of original monument and accessories and/or subsequent restoration:

B-11 1/4 CORNER COMMON TO SECTIONS 30 AND 31
 POST BY JOHN BURT, D.S. 1849
 CEDAR 12" S 12° W 24 LINKS
 YELLOW BIRCH 18" N 12° E 24 LINKS

C-11 CORNER COMMON TO SECTIONS 29 - 30 - 31- 32
 POST BY JOHN BURT, D.S. 1849
 HEMLOCK 12" S 71° E 30 LINKS
 CEDAR 16" N 46° W 9 LINKS

B. Description of corner evidence found and/or method applied in restoring or reestablishing corner:

B-11 FOUND KIMBERLY-CLARKE CORP. 4" BRASS CAP SPERHAKE, RLS 7876. DATE STAMPED 5-23-60. THE TWO WITNESSES ARE ROTTEN STUMPS.

C-11 FOUND KIMBERLY-CLARKE CORP. 4" BRASS CAP SPERHAKE, RLS 7876. DATE STAMPED 5-19-60.

1960 BEARING TREES
 3" WHITE BIRCH N 49° E 22 LINKS
 POPLAR S 16° E 17 LINKS


1960 BEARING TREES
 8" SPRUCE N 63° E 81 LINKS
 4" SPRUCE N 27° W 41 LINKS
 6" SPRUCE S 19° W 65 LINKS

C. Description of monument for corner and accessories established to perpetuate locating the position of the corner:

B-11 FOUND ABOVE MONUMENT IN PLACE NEW WITNESSES
 6" MAPLE N 88° W 9.04' NAIL/TAG
 5" MAPLE N 33° E 24.48' NAIL/TAG
 7" WHITE BIRCH S 35° E 11.52' NAIL/TAG
 7" MAPLE S 15° W 32.08' NAIL/TAG
 CARSONITE MARKER NORTH 1.00'

C-11 FOUND ABOVE MONUMENT IN PLACE NEW WITNESSES
 5" MAPLE S 5° E 7.07' NAIL/TAG
 5" SPRUCE N 20° E 17.44' NAIL/TAG
 5" SPRUCE S 86° W 8.67' NAIL/TAG
 11" MAPLE N 86° E 37.55' NAIL/TAG
 CARSONITE MARKER S 80° W 1.10'

Signed by _____ Date 11-8-99
 Surveyor's Michigan License No. 28423

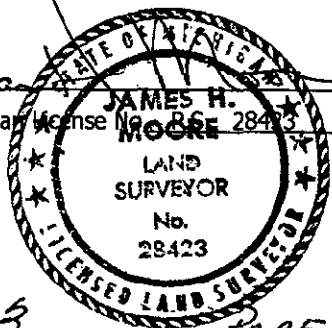

FORM APPROVED BY THE MICHIGAN STATE BOARD ON PROFESSIONAL SURVEYORS, JAN. 28, 1971
 SURVEY PEER GROUP AS THE OFFICIAL CORNER UNDER MICHIGAN PUBLIC ACT 345 OF 1990 AT A MEETING HELD ON

REVISED MAY 14, 1975
 REVISED JAN., 1983
 REVISED OCT., 1995

Liber 3

PAGE 21

11-23-99

 COUNTY REPRESENTATIVE