

MAY 07 1997

COMMISSION

LAND CORNER RECORDATION CERTIFICATE
Filing Requirement of Act 74, Mich. P.A. 1970

REGISTER OF DEEDS
DICKINSON COUNTY
IRON MOUNTAIN, MICH. 49901

1996 DEC 18 AM 8:56

RECORDED

For corners in

<u>Dickinson</u> (County)	Located In:	Corner Code #
1. Public Land Survey	T <u>42N</u> R <u>30W</u>	<u>C-1</u> & <u>D-1</u> ✓
	T _____ R _____	_____
	T _____ R _____	_____
	T _____ R _____	_____
2. Property Controlling in Section	S _____ T _____ R _____	_____
	S _____ T _____ R _____	_____
3. Miscellaneous Property in Sec.	S _____ T _____ R _____	_____
	S _____ T _____ R _____	_____

Register of Deeds Stamp & File Number

4. Lot No. _____, Recorded Plat _____
5. Private Claims _____

	A	B	C	D	E	F	G	H	I	J	K	L	M
2	6	5	4	3	2	1							
3													
4	7	8	9	10	11	12							
5													
6	18	17	16	15	14	13							
7													
8	19	20	21	22	23	24							
9													
10	30	29	28	27	26	25							
11													
12	31	32	33	34	35	36							
13													

I, Edward Kazianka, in a field survey on December 10, 1996, do hereby certify that under requirements of P.A. 74, Michigan P.A. of 1970, the corner points mentioned in lines 1 and 2 above were in conformance with regulations and rules therefore as required in the current manual of survey instructions of the United States Department of the Interior, Bureau of Land Management or by a decree of a Court of Law and/or that the corner points mentioned in lines 3, 4 and 5 above were in conformance with the rules of the Michigan Board of Land Surveyors or by a Decree of a Court of Law; established, re-established, monumented, re-monumented, recovered, found as expressed below:

NOTE: Not more than 4 corners, all in the same town and range, may be recorded on this certificate.

A. Description of original monument and accessories and/or subsequent restoration:

C-1 Northwest corner of Section 5.
Wood post set by John Burt, D.S. 1845.
Cedar 14" N70E 17 Lks. W. Pine 36" N65W 24 Lks.
Y. Birch 12" S60E 55 Lks. Y. Birch 12" S68W 40 Lks.

D-1 North 1/4 corner of Section 5.
Wood post set by John Burt, D.S. 1845.
Sugar 5" N30E 04 Lks. Sugar 18" N70W 20 Lks.

ACCEPTED BY THE DICKINSON COUNTY SURVEY PEER GROUP AS THE OFFICIAL CORNER UNDER MICHIGAN PUBLIC ACT 345 OF 1990 AT A MEETING HELD ON 12-18-96
RJP
COUNTY REPRESENTATIVE

B. Description of corner evidence found and/or method applied in restoring or reestablishing corner:


C-1 Found Kimberly-Clark pipe and cap set by N. Sperhake, R.L.S. 7876, on may 10, 1961.
Maple 12" S62E 102 Lks. (Tree living.) Maple 4" N70W 80 Lks. (Tree gone.)
Elm 10" N63E 78 Lks. (Tree cut down.) Elm 14" S32W 28 1/2 Lks. (Tree dead.)
Corner recorded on Page 593 in the office of the Dickinson County Road Commission.

D-1 No evidence of the original corner or accessories found. Section corners 1/2 mile east and west are set with a distance of 5309.54 feet between them. Five feet south and two west of the mid-point between the section corners is a point located in the center of the county road and 33 feet south of an old fence corner in the fence running along the county road. Timber is cut to the old fence line running to the south from the road. Have accepted this point as the Quarter Corner location and set a 3/4 inch by eighteen inch iron pin six inches below the gravel road surface to mark the corner.

C. Description of monument for corner and accessories established to perpetuate locating the position of the corner:

C-1 Kimberly-Clark pipe and cap. Set Carsonite stake 3.0 feet to the North.
Maple 24" N 08E 10.35 feet. Maple 7" N66W 53.68 feet.
" 9" S51W 11.45 feet. " 18" S56E 67.30 feet.

D-1 3/4 inch iron pin.
Set Dickinson County Remonumentation Witness Corner 32.00 feet North of iron pin.
Lynn 12" S57W 48.17 feet. Double W. Birch 3" S68E 68.13 feet.
Elm 7" N36E 46.82 feet. Power pole #88-24707 N62W 73.06 feet.
Set Carsonite stake by the Witness Corner.

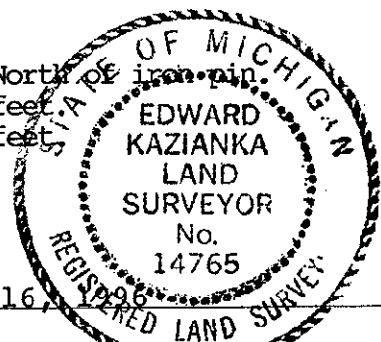

Signed by Edward Kazianka Date December 16, 1996
Surveyor's Michigan License No. 14765