

**SURVEY & REMONUMENTATION**

DEC 18 1995

**COMMISSION**

**LAND CORNER RECORDATION CERTIFICATE**  
**Filing Requirement of Act 74, Mich. P.A. 1970**

RECORDED  
 1995 NOV 21 AM 11:25

For corners in

Dickinson County	Located In:	Corner Code #/:
1. Public Land Survey	T 42 N R 30 W	B-3
	T 42 N R 30 W	C-3
	T 42 N R 30 W	C-4
	T R	
2. Property Controlling in Section	S T R	
	S T R	
3. Miscellaneous Property in Sec.	S T R	
	S T R	

9W  
 13503

REGISTER OF DEEDS  
 DICKINSON COUNTY  
 1995

Register of Deeds Stamp & File Number

4. Lot No. \_\_\_\_\_, Recorded Plat \_\_\_\_\_  
 5. Private Claims \_\_\_\_\_

	A	B	C	D	E	F	G	H	I	J	K	L	M
2	6		5		4		3		2		1		
3													
4	7		8		9		10		11		12		
5													
6	18		17		16		15		14		13		
7													
8	19		20		21		22		23		24		
9													
10	30		29		28		27		26		25		
11													
12	31		32		33		34		35		36		
13													

I, Ewart C. Muller, in a field survey on October 10, 19 95, do hereby certify that under requirements of P.A. 74, Michigan P.A. of 1970, the corner points mentioned in lines 1 and 2 above were in conformance with regulations and rules therefore as required in the current manual of survey instructions of the United States Department of the Interior, Bureau of Land Management or by a decree of a Court of Law and/or that the corner points mentioned in lines 3, 4 and 5 above were in conformance with the rules of the Michigan Board of Land Surveyors or by a Decree of a Court of Law; established, re-established, monumented, re-monumented, recovered, found as expressed below:

**NOTE: Not more than 4 corners, all in the same town and range, may be recorded on this certificate.**

Township Subdivided by John Burt, D.S. in 1850.

A. Description of original monument and accessories and/or subsequent restoration:

- B-3 Set Sugar 1/4 Section post. Var. 6°30'E. BT's: Y. Birch 16 N22W 31 lks; Sugar 10 S25E 12 lks.
- C-3 Set Ironwood post Corner of Sections 5,6,7 & 8. BT's: Hemlock 10 N48E 25 lks; Y. Birch 16 S50W 25 lks.
- C-4 Set Hemlock 1/4 Section post. Var. 6°00'E. BT's: Hemlock 10 N39E 32 lks; Tamarack 18 S39W 39 lks.

B. Description of corner evidence found and/or method applied in restoring or reestablishing corner:


- B-3 Found Kimberly-Clark capped iron pipe, Marked 1/4 corner between Sections 6 & 7, Sperhake RLS 7876, 5/12/61. Found NBT's: Mpl 4 N46W 61½ lks(overgrown); Mpl 4 S62W 82 lks(overgrown.)
- C-3 Found Kimberly-Clark capped iron pipe, Marked corner of Sections 5,6,7 & 8, Sperhake RLS 7876, 5/12/61. Found NBT's: Basswood 5 N22E 35 lks; R.Pine 3 N44W 14½ lks; Mpl 4 S30W 54 lks; Mpl 3 S48E 45½ lks. (All overgrown.)
- C-4 Found Kimberly-Clark capped iron pipe, Marked 1/4 corner between Sections 7 & 8, Sperhake, RLS 7876, 5/12/61. NBT's: Cedar 4 S58W 21 lks; Mpl 5 N86E 62 lks.(NBT's destroyed by Road construction.)

Note: These corners were set by Sperhake during the Re-tracement Survey of the entire Township in 1960 & 1961.  
 ACCEPTED BY THE DICKINSON COUNTY SURVEY PEER GROUP AS THE OFFICIAL CORNER UNDER MICHIGAN PUBLIC ACT 345 OF 1990 AT A MEETING HELD ON 11-20-95

C. Description of monument for corner and accessories established to perpetuate locating the position of the corner:

- B-3 K.C. Capped iron pipe. NBT's: Mpl 10 N46W 40.12; Mpl 10 S62W 54.00; R.Pine S78E 32.82; R.Pine 5 S12E 24.50. Carsonite Stake, East 2.45.
- C-3 K.C. Capped iron pipe. NBT's: R.Pine 7 N38W 9.78; Basswood 10 N22E 23.15; Mpl 9 S48E 29.80; Mpl 14 S30W 35.73; Carsonite Stake, East 1.70.
- C-4 K.C. Capped iron pipe. NBT's: Mpl 6 N50W 19.92; Db1. Y. Birch 5 North 35.10; Tamarack 4 N48E 17.70; Mpl 4 S28W 27.05; Carsonite Stake, East 2.00.

Note: All Bearings are Magnetic. Measurements made to 16d nails in centerline of sides of trees.

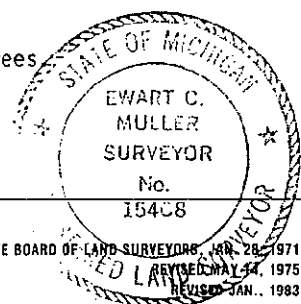

Signed by Ewart C Muller Date November 8, 1995.

Surveyor's Michigan License No. 15408

173