

**LAND CORNER RECORDATION CERTIFICATE**  
**Filing Requirement of Act 74, Mich. P.A. 1970**

RECORDED  
 1999 NOV 30 PM 3:24

For corners in

DICKINSON Located In: \_\_\_\_\_ Corner Code # \_\_\_\_\_  
 (County)

SAGOLA TOWNSHIP

1. Public Land Survey T 42 N R 30 W E-10  
 T 42 N R 30 W E-11  
 T \_\_\_\_\_ R \_\_\_\_\_  
 T \_\_\_\_\_ R \_\_\_\_\_  
 2. Property Controlling S \_\_\_\_\_ T \_\_\_\_\_ R \_\_\_\_\_  
 in Section S \_\_\_\_\_ T \_\_\_\_\_ R \_\_\_\_\_  
 3. Miscellaneous S \_\_\_\_\_ T \_\_\_\_\_ R \_\_\_\_\_  
 Property in Sec. S \_\_\_\_\_ T \_\_\_\_\_ R \_\_\_\_\_

REGISTERED  
 MICHIGAN  
 COUNTY

Register of Deeds Stamp & File Number

MAR 24 2000

4. Lot No. \_\_\_\_\_, Recorded Plat \_\_\_\_\_ SECTION \_\_\_\_\_

5. Private Claims \_\_\_\_\_

I, JAMES H. MOORE, in a field survey on AUGUST 3, 19 99 do hereby state that under requirements of P.A. 74, Michigan P.A. of 1970, the corner points mentioned in lines 1 and 2 above were in conformance with regulations and rules therefore as required in the current manual of survey instructions of the United States Department of the Interior, Bureau of Land Management or by a decree of a Court of Law and /or that the corner points mentioned in lines 3, 4 and 5 above were in conformance with the rules of the Michigan Board of Land Surveyors or by a Decree of a Court of Law; established, re-established, monumented, recovered, found as expressed below:

	A	B	C	D	E	F	G	H	I	J	K	L	M
1													
2	6		5		4		3		2		1		
3													
4	7		8		9		10		11		12		
5													
6	18		17		16		15		14		13		
7													
8	19		20		21		22		23		24		
9													
10	30		29		28		27		26		25		
11													
12	31		32		33		34		35		36		
13													

**NOTE: Not more than 2 corners, all in the same town and range, may be recorded on this certificate.**

A. Description of original monument and accessories and/or subsequent restoration:

<u>E-10</u> ¼ CORNER COMMON TO SECTIONS 28-29 WHITE PINE POST BY JOHN BURT, D.S. 1849 YELLOW BIRCH 16" N 25° E 13 LINKS WHITE PINE 5" S 7° W 35 LINKS	<u>E-11</u> CORNER COMMON TO SECTIONS 28-29-32-33 CEDAR POST BY JOHN BURT, D.S. 1849 CEDAR 8" S 25° W 35 LINKS YELLOW BIRCH 16" N 39° E 21 LINKS
--	---


B. Description of corner evidence found and/or method applied in restoring or reestablishing corner:

<u>E-10</u> FOUND KIMBERLY-CLARKE CORP. 4" ALUMINUM CAP SPERHAKE, RLS 7876. DATE STAMPED 8-4-60.  1960 BEARING TREES SPRUCE 7" N 30° E 66 LINKS ELM 8" N 56° W 93 LINKS	<u>E-11</u> FOUND KIMBERLY-CLARKE CORP. 4" ALUMINUM CAP SPERHAKE, RLS 7876. DATE STAMPED 5-19-60.  1960 BEARING TREES JACK PINE 4" S 45° W 29 LINKS JACK PINE 5" S 37° E 25 LINKS
--	--

C. Description of monument for corner and accessories established to perpetuate locating the position of the corner:

<u>E-10</u> FOUND ABOVE DESCRIBED MONUMENT IN PLACE NEW WITNESSES  FOUND 16" SPRUCE N 35° E (M.B.) 43.21' NAIL/TAG 6" ELM S 65° E (M.B.) 28.20' NAIL/TAG 8" ASH N 53° W (M.B.) 23.12' NAIL/TAG 9" ELM S 78° W (M.B.) 29.45' NAIL/TAG CARSONITE MARKER NORTH 1.0'	<u>E-11</u> FOUND ABOVE DESCRIBED MONUMENT IN PLACE NEW WITNESSES  FOUND 12" JACKPINE S 35° E (M.B.) 16.54' NAIL/TAG 8" SPRUCE S 33° E (M.B.) 8.77' NAIL/TAG 10" RED PINE S 4° W (M.B.) 31.70' NAIL/TAG 10" SPRUCE N 83° W (M.B.) 12.10' NAIL/TAG CARSONITE MARKER SOUTH 1.0'
---	--

Signed by \_\_\_\_\_ Date 11-8-99  
 Surveyor's Michigan License No. 28423

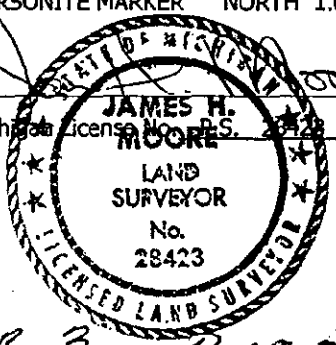

FORM APPROVED BY MICHIGAN STATE BOARD OF PROFESSIONAL SURVEYORS, JAN. 28, 1971  
 AS ADOPTED BY THE DICKINSON COUNTY SURVEY PLEER GROUP AS THE OFFICIAL CORNER UNDER MICHIGAN PUBLIC ACT 346 OF 1990 AT A MEETING HELD ON

REVISED MAY 14, 1975  
 REVISED JAN., 1983  
 REVISED OCT., 1995

*Liber 3 PAGE 24*

*11-23-99*  
 \_\_\_\_\_  
 COUNTY REPRESENTATIVE