

**SURVEY &
MONUMENTATION**

DEC 18 1995

COMMISSION

LAND CORNER RECORDATION CERTIFICATE
Filing Requirement of Act 74, Mich. P.A. 1970

RECORDED

1995 NOV -7 AM 9:23

For corners in

<u>Dickinson</u> (County)	Located In:	Corner Code #
1. Public Land Survey	T <u>L2N</u> R <u>30W</u>	<u>E-1 & F-1</u>
	T _____ R _____	_____
	T _____ R _____	_____
	T _____ R _____	_____
2. Property Controlling in Section	S _____ T _____ R _____	_____
	S _____ T _____ R _____	_____
3. Miscellaneous Property in Sec.	S _____ T _____ R _____	_____
	S _____ T _____ R _____	_____
4. Lot No. _____, Recorded Plat _____		
5. Private Claims _____		

REGISTER OF DEEDS
DICKINSON COUNTY

Register of Deeds Stamp & File Number

I, Edward Kazianka, in a field survey on July 14, 19 95, do hereby certify that under requirements of P.A. 74, Michigan P.A. of 1970, the corner points mentioned in lines 1 and 2 above were in conformance with regulations and rules therefore as required in the current manual of survey instructions of the United States Department of the Interior, Bureau of Land Management or by a decree of a Court of Law and/or that the corner points mentioned in lines 3, 4 and 5 above were in conformance with the rules of the Michigan Board of Land Surveyors or by a Decree of a Court of Law; established, re-established, monumented, re-monumented, recovered, found as expressed below:

NOTE: Not more than 4 corners, all in the same town and range, may be recorded on this certificate.

	A	B	C	D	E	F	G	H	I	J	K	L	M
2	6	5	4	3	2	1							
3													
4	7	8	9	10	11	12							
5													
6	18	17	16	15	14	13							
7													
8	19	20	21	22	23	24							
9													
10	30	29	28	27	26	25							
11													
12	31	32	33	34	35	36							
13													

A. Description of original monument and accessories and/or subsequent restoration:

E-1 Wood Post Y. Birch 12 S60E 55 lks. Cedar 14 N70E 17 lks.
" 12 S68W 10 lks. W. Pine 36 N65W 24 lks.

Four inch Aluminum cap on a one inch iron pipe set by N. Sperhake, FLS 7876 in 1961.
Cap is stamped "W.C. Corner is 24 feet North. W.C."
Cedar 7 S16W 56 lks. B. Ash 5 N84E 16 1/2 lks.

F-1 Wood Post Cedar 14 N72E 34 lks. Y. Birch 22 N45W 47 lks.
5/8 inch iron pin set in center of county road by persons unknown.

B. Description of corner evidence found and/or method applied in restoring or reestablishing corner:

E-1 Four inch Aluminum cap and pipe. Cedar B.T. still alive.


F-1 5/8 inch iron pin found 14 inches below surface of road. Pin in line with old fence to the south and the edge of the field to the north.

ADOPTED BY THE DICKINSON COUNTY
PEER GROUP AS THE OFFICIAL
UNDER MICHIGAN PUBLIC ACT
OF 1990 AT A MEETING HELD ON
11-6-95
REP
COUNTY REPRESENTATIVE

C. Description of monument for corner and accessories established to perpetuate locating the position of the corner:

E-1 Set a Dickinson County Survey cap/rod six inches below surface of county road. Corner is set 24 feet north of the witness corner.
Cedar 12 S16W 60.24 feet. B. Ash 3 S44W 54.55 feet. Witness corner South 24.00 feet.
Aspen 6 S25E 32.15 feet. P.Pole N69W 77.27 feet.

F-1 Set a Dickinson County Survey cap/rod in place of 5/8 inch iron pin. Corner is set six inches below surface of road.
Spruce 20 N56E 65.10 feet. Balsam 7 S57E 52.35 feet.
Y. Birch 7 S44W 36.65 feet. Maple 4 S09W 25.75 feet.

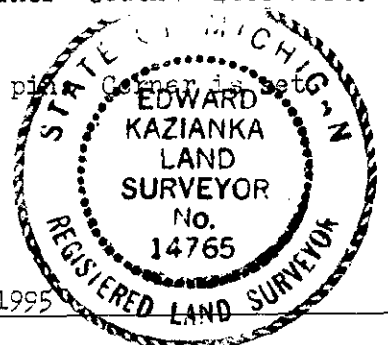

Signed by Edward Kazianka Date August 25, 1995
Surveyor's Michigan License No. 14765

173