

**SURVEY &
REMONUMENTATION**

DEC 18 1995

COMMISSION

**LAND CORNER RECORDATION CERTIFICATE
Filing Requirement of Act 74, Mich. P.A. 1970**

RECORDED

1995 NOV -7 AM 9:23

For corners in

<u>Dickinson</u> (County)	Located In:	Corner Code #/
1. Public Land Survey	T <u>L2N</u> R <u>30E</u>	<u>G-1 & G-2</u>
	T _____ R _____	_____
	T _____ R _____	_____
	T _____ R _____	_____
2. Property Controlling in Section	S _____ T _____ R _____	_____
	S _____ T _____ R _____	_____
3. Miscellaneous Property in Sec.	S _____ T _____ R _____	_____
	S _____ T _____ R _____	_____
4. Lot No. _____, Recorded Plat _____		
5. Private Claims _____		

REGISTER OF DEEDS
DICKINSON COUNTY

Register of Deeds Stamp & File Number

	A	B	C	D	E	F	G	H	I	J	K	L	M
2	6	5	4	3	2	1							
3													
4	7	8	9	10	11	12							
5													
6	18	17	16	15	14	13							
7													
8	19	20	21	22	23	24							
9													
10	30	29	28	27	26	25							
11													
12	31	32	33	34	35	36							
13													

I, Edward Kazianka, in a field survey on July 10, 1995, do hereby certify that under requirements of P.A. 74, Michigan P.A. of 1970, the corner points mentioned in lines 1 and 2 above were in conformance with regulations and rules therefore as required in the current manual of survey instructions of the United States Department of the Interior, Bureau of Land Management or by a decree of a Court of Law and/or that the corner points mentioned in lines 3, 4 and 5 above were in conformance with the rules of the Michigan Board of Land Surveyors or by a Decree of a Court of Law; established, re-established, monumented, re-monumented, recovered, found as expressed below:

NOTE: Not more than 4 corners, all in the same town and range, may be recorded on this certificate.

A. Description of original monument and accessories and/or subsequent restoration:

G-1 Wood Post Sugar 7 N36W 26 lks. Y. Birch 20 S25E 33 lks.
" 10 S48W 27 lks. Fir 6 N55E 44 lks.

Four inch Aluminum cap on a one inch iron pipe set by N. Sperhake, FLS 7876, in 1961.
Poplar 5 N58E 32½ lks. Balsam L N40W 12½ lks.
Poplar 3 S68E 55 lks.

G-2 Wood Post Sugar 14 N63W 17 lks. Sugar 14 S43E 18 lks.

B. Description of corner evidence found and/or method applied in restoring or reestablishing corner:

G-1 Four inch Aluminum cap and pipe. One B.T. still alive.

G-2 No evidence of the original corner or accessories found. Set the corner by single proportionate measurement. Quarter Corner is set on line between and 2632.69 feet south of the Section Corner and 2636.65 feet north of the corner common to sections 3, 4, 9 and 10.

ACCEPTED BY THE DICKINSON COUNTY SURVEY PEER GROUP AS THE OFFICIAL CORNER UNDER MICHIGAN PUBLIC ACT 345 OF 1980 AT A MEETING HELD ON


11-6-95
REP

COUNTY REPRESENTATIVE

C. Description of monument for corner and accessories established to perpetuate locating the position of the corner:

G-1 Four inch Aluminum cap on a one inch iron pipe.
Aspen 10 N60E 21.40 feet. Maple 9 N86W 12.60 feet.
" 11 N43W 21.80 feet. " 6 S19E 33.25 feet.

G-2 Set a Dickinson County Survey cap/rod.
Maple 6 N44E 9.35 feet. Maple 5 N65W 13.77 feet.
" 7 S43W 15.83 feet. " 7 S38E 9.95 feet.

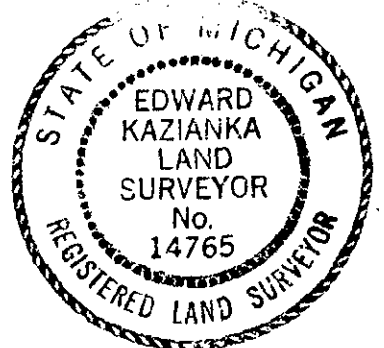

Signed by Edward Kazianka
Surveyor's Michigan License No. 14765

Date August 25, 1995

169