

RECORDED

1999 NOV 30 PM 3:24

H-1/H-13 T42N-R30W
G-1/G-13 T42N-R30W

LAND CORNER RECORDATION CERTIFICATE
Filing Requirement of Act 74, Mich. P.A. 1970

For Corners In

DICKINSON
(County)

Located In:

Corner Code #

SAGOLA TOWNSHIP

- 1. Public Land Survey T 41 N R 30 W H-1
T 41 N R 30 W G-1
T R
T R
- 2. Property Controlling S T R
in Section S T R
- 3. Miscellaneous S T R
Property in Sec. S T R

SURVEY &
REMONUMENTATION

REGISTERED
DIGITAL
STAMP

Register of Deeds Stamp & File
Number

MAR 24 2000

4. Lot No. _____, Recorded Plat _____

5. Private Claims _____ SECTION _____

I, JAMES H. MOORE, in a field survey on NOVEMBER 4, 19 99 do hereby state that under requirements of P.A. 74, Michigan P.A. of 1970, the corner points mentioned in lines 1 and 2 above were in conformance with regulations and rules therefore as required in the current manual of survey instructions of the United States Department of the Interior, Bureau of Land Management or by a decree of a Court of Law and /or that the corner points mentioned in lines 3, 4 and 5 above were in conformance with the rules of the Michigan Board of Land Surveyors or by a Decree of a Court of Law; established, re-established, monumented, recovered, found as expressed below:

	A	B	C	D	E	F	G	H	I	J	K	L	M
1													
2		6		5		4		3		2		1	
3													
4		7		8		9		10		11		12	
5													
6		13		17		16		15		14		13	
7													
8		19		20		21		22		23		24	
9													
10		30		29		28		27		26		25	
11													
12		31		32		33		34		35		36	
13													

NOTE: Not more than 2 corners, all in the same town and range, may be recorded on this certificate.

A. Description of original monument and accessories and/or subsequent restoration:

H-1 1/4 CORNER COMMON TO SECTION 3 T41N-R30W AND SECTION 34 T42N-R30W
HEMLOCK POST BY WILLIAM A. BURT, D.S. 1846
FIR 4" N 06°E 8 LINKS
YELLOW BIRCH 10" N 29°W 22 LINKS

G-1 CORNER COMMON TO SECTIONS 3-4, T41N-R30W AND SECTIONS 33-34 T42N-R30W
HEMLOCK POST BY WILLIAM A. BURT, D.S. 1846
HEMLOCK 8" N31°E 10 LINKS
SPRUCE 6" N48°E 20 LINKS

B. Description of corner evidence found and/or method applied in restoring or reestablishing corner:

H-1 SET CORNER AT INTERSECTION OF N-S FENCE WITH A FENCE HEADING WEST, ALSO FOUND A MSHD BEARING TREE (YELLOW BIRCH) AND THE DISTANCE TO THE WEST SECTION CORNER MATCHED, SET CORNER AT BASE OF STANDING FENCE POST.

G-1 SET CORNER AT FOUND 1 1/4" CAPPED PIPE PER ACT 74 BY JAMES H. MOORE PS #28423. I ACCEPTED THIS AS THE SECTION CORNER. THE DICKINSON COUNTY SURVEY PEER GROUP AS THE OFFICIAL CORNER UNDER MICHIGAN PUBLIC ACT 345 OF 1990 AT A MEETING HELD ON 11-23-99

C. Description of monument for corner and accessories established to perpetuate locating the position of the corner.


H-1 SET DICKINSON COUNTY MONUMENT WITH 4" ALUMINUM CAP.
NEW WITNESSES
EXISTING 5" SPRUCE S 33° E (M.B.) 22.20' NAIL/TAG
EXISTING 12" YELLOW BIRCH S 55° E (M.B.) 23.40' NAIL/TAG
11" TWIN WHITE BIRCH N 07° E (M.B.) 25.40' NAIL/TAG
9" BALSAM S 88° E (M.B.) 45.57' NAIL/TAG
CARSONITE MARKER N 55° E 1.75'

G-1 SET DICKINSON COUNTY MONUMENT INSIDE EXISTING PIPE WITH 4" ALUMINUM CAP.
NEW WITNESSES
P.P. 82-23106 S61°E (M.B.) 42.02' NAIL/TAG
5" BALSAM N53°E (M.B.) 21.28' NAIL/TAG
8" BALSAM N46°W (M.B.) 26.14' NAIL/TAG
7" BALSAM S51°W (M.B.) 76.56' NAIL/TAG
CARSONITE MARKER NORTH 1.0'

Signed by

Date 11-8-99

Surveyor's Michigan License No. 28423

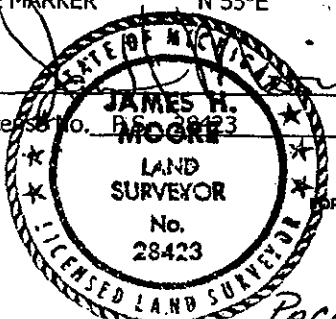

ACCEPTED BY THE DICKINSON COUNTY SURVEY PEER GROUP AS THE OFFICIAL CORNER UNDER MICHIGAN PUBLIC ACT 345 OF 1990 AT A MEETING HELD ON 11-23-99

Liber 3

PAGE 19

R.F. Bond

REVISED OCT., 1995