

**SURVEY &  
REMONUMENTATION**

MAY 07 1997

COMMISSION

**LAND CORNER RECORDATION CERTIFICATE**  
Filing Requirement of Act 74, Mich. P.A. 1970

RECORDED  
1996 DEC 18 AM 11:16

For corners in

DICKINSON (County)

Located In:

Corner Code #

SAGOLA TWP.

1. Public Land Survey	T	<u>42N</u>	R	<u>30W</u>	<u>K-7</u>
	T		R		<u>L-7</u>
	T		R		
	T		R		
2. Property Controlling in Section	S		T		
	S		T		
3. Miscellaneous Property in Section	S		T		
	S		T		

REGISTER OF DEEDS  
DICKINSON COUNTY  
IRON MOUNTAIN, MI. 49801

Register of Deeds Stamp & File Number

4. Lot No. \_\_\_\_\_, Recorded Plat \_\_\_\_\_  
5. Private Claims \_\_\_\_\_

I, ROBERT F. PERKINS, in a field survey on 7-16, 19 96, do hereby certify that under requirements of P.A. 74, Michigan P.A. of 1970, the corner points mentioned in lines 1 and 2 above were in conformance with regulations and rules therefore as required in the current manual of survey instructions of the United States Department of the Interior, Bureau of Land Management or by a decree of a Court of Law and/or that the corner points mentioned in lines 3, 4 and 5 above were in conformance with the rules of the Michigan Board of Professional Surveyors or by a Decree of a Court of Law; established, re-established, monumented, re-monumented, recovered, found as expressed below:

A	B	C	D	E	F	G	H	I	J	K	L	M
2	6		5		4		3		2		1	
3												
4	7		8		9		10		11		12	
5												
6	18		17		16		15		14		13	
7												
8	19		20		21		22		23		24	
9												
10	30		29		28		27		26		25	
11												
12	31		32		33		34		35		36	
13												

**NOTE: Not more than 4 corners, all in the same town and range, may be recorded on this certificate.**

**A. Description of original monument and accessories and/or subsequent restoration:**

K-7 CORNER COMMON TO SECTIONS 13-14-23-24  
SET Y. BIRCH POST J. BURT 1849  
ORIGINAL BEARING TREES  
SPRUCE 18" N20°E 49 L.  
Y. BIRCH 16" S67°W 30 L.

L-7 QUARTER CORNER COMMON TO SECTIONS <sup>13</sup>/<sub>24</sub>  
SET Y. BIRCH  $\frac{1}{4}$  POST J. BURT 1849  
ORIGINAL BEARING TREES  
Y. BIRCH 18" S4°E 40 L.  
W. PINE 24" N14°W 31 L.

**B. Description of corner evidence found and/or method applied in restoring or reestablishing corner:**

K-7 NO EVIDENCE OF ORIGINAL CORNER OR ACCESSORIES FOUND.  
FOUND 4" STAMPED K.C. CORP. IRON PIPE MONUMENT SET BY N. SPERHAKE IN 1960 (#508) IN PLACE.


L-7 NO EVIDENCE OF ORIGINAL CORNER OR ACCESSORIES FOUND.  
FOUND 4" STAMPED K.C. CORP. IRON PIPE MONUMENT SET BY N. SPERHAKE IN 1960 (#497) IN PLACE.

THE DICKINSON COUNTY  
SURVEYOR GROUP AS THE OFFICIAL  
GROUP UNDER MICHIGAN PUBLIC ACT  
OF 1990 AT A MEETING HELD ON  
12-17-96  
R.O.P.  
COUNTY REPRESENTATIVE

**C. Description of monument for corner and accessories established to perpetuate locating the position of the corner:**

K-7 ACCEPTED ABOVE DESCRIBED MONUMENT.  
NEW WITNESSES:  
SPRUCE 4" N12°W (M.B.) 14.15'  
CHERRY 5" N70°E (M.B.) 18.35'  
FIR 7" S78°W (M.B.) 32.81'  
SPRUCE 4" N59°W (M.B.) 35.94'  
TAG ON 10" ASPEN SOUTH 2.0'

L-7 ACCEPTED ABOVE DESCRIBED MONUMENT.  
NEW WITNESSES:  
MAPLE 10" S28°E (M.B.) 16.40'  
MAPLE 8" N63°E (M.B.) 15.55'  
MAPLE 12" N37°W (M.B.) 56.90'  
FIR 3" N18°W (M.B.) 36.00'

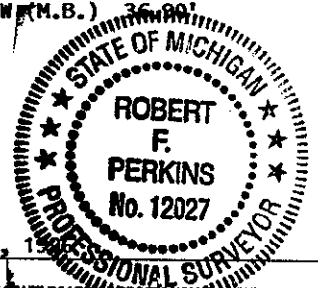

Signed by Robert F. Perkins

Date DECEMBER 2, 1996

Surveyor's Michigan License No. 12027

FORM APPROVED BY MICHIGAN STATE BOARD OF PROFESSIONAL SURVEYORS, JAN. 28, 1971  
REVISED MAY 14, 1975  
REVISED JAN., 1983