

**SURVEY &
REMONUMENTATION**

MAR 03 1998

SECTION

**LAND CORNER RECORDATION CERTIFICATE
Filing Requirement of Act 74, Mich. P.A. 1970**

RECORDED

1997 NOV 13 AM 9:31

For corners in

<u>Dickinson</u> (Sagola Township)	Located In:	Corner Code #
1. Public Land Survey	T 42N R 30W	M-3
	T 42N R 30W	M-4
	T ___ R ___	_____
	T ___ R ___	_____
2. Property Controlling in Section	S ___ T ___ R ___	_____
	S ___ T ___ R ___	_____
3. Miscellaneous Property in Sec.	S ___ T ___ R ___	_____
	S ___ T ___ R ___	_____

REGISTER OF DEEDS
DICKINSON COUNTY
RON K... ..

Register of Deeds Stamp & File Number

4. Lot No. _____, Recorded Plat _____
5. Private Claims _____

I, Ewart C. Muller, in a field survey on October 9, 1997 do hereby state that under requirements of P.A. 74, Michigan P.A. of 1970, the corner points mentioned in lines 1 and 2 above were in conformance with regulations and rules therefore as required in the current manual of survey instructions of the United States Department of the Interior, Bureau of Land Management or by a decree of a Court of Law and/or that the corner points mentioned in lines 3, 4 and 5 above were in conformance with the rules of the Michigan Board of Land Surveyors or by a Decree of a Court of Law; established, re-established; monumented, recovered, found as expressed below:

NOTE: Not more than 2 corners, all in the same town and range, may be recorded on this certificate.

Surveyed by Wm.A. Burt, D.S. 1851

A. Description of original monument and accessories and/or subsequent restoration:

M-3 Set Fir Post, corner of Sections 1 & 12
BT's: Spruce 10 S16E 21 lks Sugar 10 N42W 17 lks

M-4 set sugar post, quarter section corner
BT's: Mpl 8 S82E 14 lks; Cedar 10 N34W 33 lks

B. Description of corner evidence found and/or method applied in restoring or reestablishing corner:

M-3 Spherhake, RLS 7876 set 36 x 1 inch galvanized pipe with brass cap by Proportional measure between Town Corner one mile North & 1/4 section corner of Section 13-42-30 to South. See Old Corner Report #512
NBT's: pine stp 26 N30E 82 lks; poplar 7 S50W 125 lks
poplar 7 N72W 99 lks; Basswood 16 S14E 99 lks
I found his capped pipe in center of air strip. Witnesses destroyed when air strip was built.

M-4 Spherhake, RLS 7876 set 36 x 1 inch galvanized pipe with brass cap by Proportional measure 1 1/2 miles North & 1/4 section corner of section 13-42-30. see old corner Report # 511.
NBT's: pine stp 30 N65E 82 lks. (destroyed by bears)
pine stub 30 N70W 23 lks, (standing, rotten, scribed.)
also found one inch iron pipe.

C. Description of monument for corner and accessories established to perpetuate locating the position of the corner:

M-3 Witnessed Spherhake's section corner in low grassy area in center of air strip.
NBT's: Telephone Box S7W 201.50; W. Spruce 19 S45W 99.17 ; Aspen 11 S30W 113.77;
Set 3 1/2" stamped D.C. Mon marked W.C. East 100 ft.
Set Carsonite stake by witness corner

M-4 Witnessed Spherhake's corner.
NBT's: Balsam 4 N14E 24.5; Balsam 6 S18W 15.70; Balsam 6 S52W 11.3;
one inch iron pipe N89E 11.58. Set Carsonite Stake 1.5 ft. East


Note: All measurements are to nails in side of trees. Bearings are Magnetic.

Signed by Ewart C Muller
Surveyor's Michigan License No. 15408

Date November 4, 1997

1	A	B	C	D	E	F	G	H	I	J	K	L	M
2		6		5		4		3		2		1	
3													
4		7		8		9		10		11		12	
5													
6		18		17		16		15		14		13	
7													
8		19		20		21		22		23		24	
9													
10		30		29		28		27		26		25	
11													
12		31		32		33		34		35		36	
13													

ACCEPTED BY THE DICKINSON COUNTY
SURVEY PEER GROUP AS THE OFFICIAL
CORNER UNDER MICHIGAN PUBLIC ACT
345 OF 1990 AT A MEETING HELD ON
11-12-97
RAP
COUNTY REPRESENTATIVE

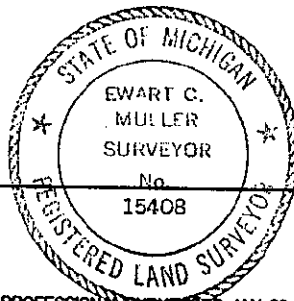

Liber 9 Page 317