

same as M-10 ✓
M-11

IN T42N, R30W

LAND CORNER RECORDATION CERTIFICATE

Filing Requirement of Act 74, Mich. P.A. 1970

For corners in

<u>Dickinson</u> (County)	Located in:	Corner Code #
<u>Felch</u>		
1. Public Land Survey	T <u>42NR 29W</u>	<u>A-10</u>
	T ___ R ___	<u>A-11</u>
	T ___ R ___	
	T ___ R ___	
2. Property Controlling in Section	S ___ T ___ R <u>DE</u>	
	S ___ T ___ R ___	
3. Miscellaneous Property in Sec.	S ___ T ___ R ___	
	S ___ T ___ R ___	

REGISTERED RECORDS
DISKINSON COUNTY
PUBLIC ACT 74 OF 1970

1998 DEC 14 AM 12:23

RECORDED

Register of Deeds Stamp & File Number

4. Lot No. _____, Recorded Plat _____ SECTION _____
5. Private Claims _____

I, Robert F. Perkins, in a field survey on Oct. 20, 1998 do hereby state that under requirements of P.A. 74, Michigan P.A. of 1970, the corner points mentioned in lines 1 and 2 above were in conformance with regulations and rules therefore as required in the current manual of survey instructions of the United States Department of the Interior, Bureau of Land Management or by a decree of a Court of Law and for that the corner points mentioned in lines 3, 4 and 5 above were in conformance with the rules of the Michigan Board of Land Surveyors or by a Decree of a Court of Law; established, re-established, monumented, recovered, found as expressed below:

NOTE: Not more than 2 corners, all in the same town and range, may be recorded on this certificate.

	A	B	C	D	E	F	G	H	I	J	K	L	M
1													
2	6		5		4		3		2		1		
3													
4	7		8		9		10		11		12		
5													
6	10		17		16		15		14		13		
7													
8	19		20		21		22		23		24		
9													
10	30		29		28		27		26		25		
11													
12	31		32		33		34		35		36		
13													

A. Description of original monument and accessories and/or subsequent restoration:

A-10 West 1/4 Corner Section 30
Post by William A. Burt, D.S. 1845
Original Bearing Trees
W. Pine 14" N46°E 23 Lk.
Fir 8" S38°W 35 Lk.

A-11 Southwest Corner Section 30
Post by William A. Burt, D.S. 1845
Original Bearing Trees
Cedar 6" N75°E 17 Lk.
Spruce 8" S76°W 12 Lk.

ACCEPTED BY THE DICKINSON COUNTY SURVEYOR AS THE OFFICIAL CORNER UNDER MICHIGAN PUBLIC ACT 345 OF 1990 AT A MEETING HELD ON
RFP
12-7-98
COUNTY REPRESENTATIVE

B. Description of corner evidence found and/or method applied in restoring or reestablishing corner:

A-10 Found K.C. Corp. Pipe Marker with 4" Brass Cap Set by N. Spherhake, RLS in 1960 from what he believed to be the Stump of a G.L.O. Bearing Tree.
1960 Bearing Trees:
Maple 5" N48°W 31 Lk.
W. Birch 6" S77°E 49 Lk.
Old Corner Report #440.


A-11 No Evidence of Original Corner or its Accessories Found.
Found 1 1/2" Solid Iron Bar projecting ±30" Set by M.A. Hanna (Circa 1950) and referred to on Old 1960 Corner Report No. 440 as having been "Previously Established".

C. Description of monument for corner and accessories established to perpetuate locating the position of the corner:

A-10 Accepted Pipe Marker described in "B" above.
New Witnesses:
Maple 3" S62°W(M.B.) 4.88' Nail/Tag
Maple 5" N14°W(M.B.) 21.80' Nail/Tag
Maple 4" N72°E(M.B.) 22.20' Nail/Tag
Maple 5" S30°E(M.B.) 12.89' Nail/Tag
Placed Carsonite Stake N59°E 1.5' from Corner.

A-11 Accepted Iron Bar described in "B" above as Best Remaining Evidence of Corner Location. Placed 2 1/2" Stamped D.C. Remon. Corner at Found Iron Bar.
New Witnesses:
Cedar 5" N16°E(M.B.) 12.85' Nail/Tag
Cedar 4" S49°E(M.B.) 19.88' Nail/Tag
Cedar 8" N60°W(M.B.) 25.08' Nail/Tag
1 1/2" Iron Bar (Tag M.A.H.) S57°W(M.B.) 33.0'. Placed Carsonite Marker 1.0' North

Signed by Robert F. Perkins Date Nov. 6, 1998
Surveyor's Michigan License No. 12027

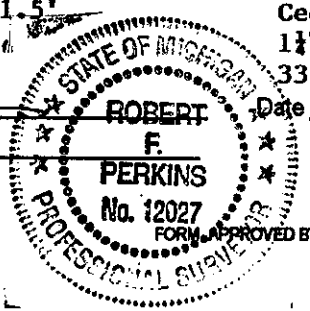

002, 384