

LAND CORNER RECORDATION CERTIFICATE
 Filing Requirement of Act 74, Mich. P.A. 1970 as Amended

For corners in

| | | |
|---------------------------------------|-------------------------|---------------|
| <u>Dickinson</u> (County) | Located In: | Corner Code # |
| West Branch Township | | |
| 1. Public Land Survey | T _____ R _____ | _____ |
| | T _____ R _____ | _____ |
| | T _____ R _____ | _____ |
| 2. Property Controlling in Section | S 21 T 43N R 27W | 15 |
| | S 21 T 43N R 27W | 16 |
| | S _____ T _____ R _____ | _____ |
| 3. Miscellaneous Property in Sec. | S _____ T _____ R _____ | _____ |
| | S _____ T _____ R _____ | _____ |
| 4. Lot No. _____, Recorded Plat _____ | | |
| 5. Private Claims | | |

Register of Deeds Stamp & File Number

| | | | | | | | | | | | | | |
|----|----|---|----|---|----|---|----|---|----|---|----|---|---|
| | A | B | C | D | E | F | G | H | I | J | K | L | M |
| 1 | | | | | | | | | | | | | |
| 2 | 6 | | 5 | | 4 | | 3 | | 2 | | 1 | | |
| 3 | | | | | | | | | | | | | |
| 4 | 7 | | 8 | | 9 | | 10 | | 11 | | 12 | | |
| 5 | | | | | | | | | | | | | |
| 6 | 10 | | 11 | | 12 | | 13 | | 14 | | 15 | | |
| 7 | | | | | | | | | | | | | |
| 8 | 19 | | 20 | | 21 | | 22 | | 23 | | 24 | | |
| 9 | | | | | | | | | | | | | |
| 10 | 30 | | 29 | | 28 | | 27 | | 26 | | 25 | | |
| 11 | | | | | | | | | | | | | |
| 12 | 31 | | 32 | | 33 | | 34 | | 35 | | 36 | | |
| 13 | | | | | | | | | | | | | |

I, Jeremy J. Pipp, in a field survey on 8/22/2012AD do hereby state that under requirements of P.A. 74, Michigan P.A. of 1970, the corner points mentioned in lines 1 and 2 above were in conformance with regulations and rules therefore as required in the current manual of survey instructions of the United States Department of the Interior, Bureau of Land Management or by a decree of a Court of Law and /or that the corner points mentioned in lines 3, 4 and 5 above were in conformance with the rules of the Michigan Board of Land Surveyors or by a Decree of a Court of Law; established, re-established, monumented, recovered, found as expressed below:

NOTE: Not more than 2 corners, all in the same town and range, may be recorded on this certificate.

A. Description of original monument and accessories and/or subsequent restoration:

(15) West One-Sixteenth corner common to Sections 21 and 28. Not set in original survey, no evidence of subsequent establishment.

(16) East One-Sixteenth corner common to Sections 21 and 28. Not set in original survey, no evidence of subsequent establishment.

B. Description of corner evidence found and/or method applied in restoring or reestablishing corner:

(15) Corner position established mid-point and on-line between the South One-Quarter corner and the Southwest corner of Section 21. Found 3/4 inch pipe with cuplink cap and 'T' intersection N09E 35 feet from calculated position; not accepted.


(16) Corner position established mid-point and on-line between the South One-Quarter corner and the Southeast corner of Section 21.

C. Description of monument for corner and accessories established to perpetuate locating the position of the corner:

| | | | |
|-----------|------------------------|----------|------------------------|
| (15) | DNR monument | (16) | DNR monument |
| 9" Maple | N37E 13.02' (1/16S,BT) | 7" Cedar | N62E 17.78' (1/16S,BT) |
| 7" Maple | S19W 26.60' (1/16S,BT) | 6" Cedar | S62E 16.76' (1/16S,BT) |
| 10" Maple | N82W 12.07' (1/16S,BT) | 8" Cedar | S14E 6.99' (1/16S,BT) |
| 19" Maple | N33W 8.31' (1/16S,BT) | 8" Cedar | N21W 11.67' (1/16S,BT) |

All trees are blazed, scribed, and painted. Measurements are to nail in side of tree, bearings are magnetic.

Signed by Jeremy J. Pipp Date August 29, 2012
 Surveyor's Michigan License No. 50447

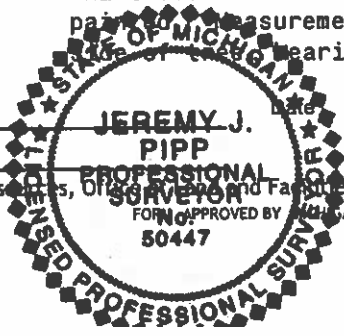

For the Michigan Department of Natural Resources, Office of Land and Fisheries

20126
20125

MICHIGAN STATE BOARD OF PROFESSIONAL SURVEYORS, JAN. 28, 1971
 Revised May 14, 1975
 Revised Jan., 1983
 Revised Oct., 1995