

# SURVEY & REMONUMENTATION

NOV 15 1999

## SECTION

### LAND CORNER RECORDATION CERTIFICATE Filing Requirement of Act 74, Mich. P.A. 1970

For corners in

<u>Dickinson</u>	Located In:	Corner Code #/	
(County)			
1. Public Land Survey	T 43N R 27 W	A-8	
	T 43N R 27 W	B-8	
	T 43N R 27 W	<u>B-9</u> ✓	
	T _____ R _____		
2. Property Controlling in Section	S _____ T _____ R _____		
	S _____ T _____ R _____		
3. Miscellaneous Property in Sec.	S _____ T _____ R _____		
	S _____ T _____ R _____		

REGISTER OF DEEDS  
DICKINSON COUNTY  
NON MONUMENTAL ACT 205(1)

1994 NOV 10 AM 9:41

RECORDED

Register of Deeds Stamp & File Number

4. Lot No. \_\_\_\_\_, Recorded Plat \_\_\_\_\_  
5. Private Claims \_\_\_\_\_

	A	B	C	D	E	F	G	H	I	J	K	L	M
2	6		5		4		3		2		1		
3													
4	7		8		9		10		11		12		
5													
6	18		17		16		15		14		13		
7													
8	•	•			20		21		22		23		24
9		•											
10	30		29		28		27		26		25		
11													
12	31		32		33		34		35		36		
13													

I, Ewart C. Muller, in a field survey on September, 1994, do hereby certify that under requirements of P.A. 74, Michigan P.A. of 1970, the corner points mentioned in lines 1 and 2 above were in conformance with regulations and rules therefore as required in the current manual of survey instructions of the United States Department of the Interior, Bureau of Land Management or by a decree of a Court of Law and/or that the corner points mentioned in lines 3, 4 and 5 above were in conformance with the rules of the Michigan Board of Land Surveyors or by a Decree of a Court of Law; established, re-established, monumented, re-monumented, recovered, found as expressed below:

**NOTE: Not more than 4 corners, all in the same town and range, may be recorded on this certificate.**

Township Subdivided by John Burt DS 1847

**A. Description of original monument and accessories and/or subsequent restoration:**

- A-8 Set cedar Qr. Section Post between Section 24-43-28 & Section 19-43-27 (E.R. Nelson found post 1931 Road Survey)  
BT's: Sugar 8 N52½E 25 lks; Sugar 8 S48W 7 lks. (Destroyed during road construction)
- B-8 Not set in Original Survey. (Center 1/4 corner of Section 19-43-27)
- B-9 Set cedar post corner (1/4 between Sections 19 & 30 43-27) (Gingrass found post. Set new one. 1921 Road survey.)  
BT's: Cedar 10 N56W 26 lks; Elm 20 S10E 14 lks.

**B. Description of corner evidence found and/or method applied in restoring or reestablishing corner:**

- A-8 E.R. Nelson drove round iron during 1931 Road Survey. (Found RR spike over round iron)
- B-8 Found Cedar post/5/8-inch round iron pin as recorded in 1905 Road Survey. (Centerline PI.)
- B-9 E.R. Nelson found Gingrass's Post and set rerod in 1931 Road Survey (Centerline PI) (Found rerod)


ACCEPTED BY THE DICKINSON COUNTY  
SURVEY PEER GROUP AS THE OFFICIAL  
CORNER UNDER MICHIGAN PUBLIC ACT  
345 OF 1990 AT A MEETING HELD ON  
11-7-94  
R.O.P.  
COUNTY REPRESENTATIVE

**C. Description of monument for corner and accessories established to perpetuate locating the position of the corner:**

- A-8 Set Dickinson County Cap/rod in Monument Box. NBT's: PP# 86-25348 N48W 52.17; Aspen 9 S30E 46.52;  
NBT's: Fillis Road Sign iron pipe N36E 41.70; PP# 93-22448 S50W 26.80.
- B-8 Set Dickinson County Cap/rod with Carsonite Stake. BT's: Spruce 12 N60W 45.40; Spruce 12 N18W 34.40;  
BT's: Db1. Spruce 11 N65E 18.35; Spruce 12 S52E 11.60.
- B-9 Set Dickinson County Cap/rod with Carsonite Stake at found rerod. NBT's: Aspen 7 N85E 12.00; Aspen 12 S10W 20.40;  
NBT's: 1½x48-inch I.D. iron pipe @ corner fence post. West 34.49; USGS Monument TT34S 1933 West 1.38

Note: Bearings are Magnetic. Distances measured to center of pipes and 16d nails in side of trees or poles

Signed by Ewart C Muller Date November 7, 1994  
Surveyor's Michigan License No. 15408

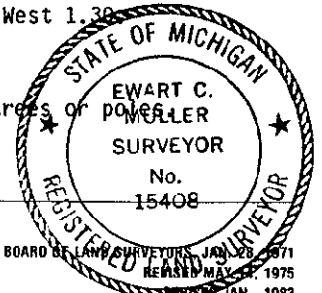

Liber 2 Page 108