

MICHIGAN
DEPARTMENT OF CONSERVATION
FORESTRY DIVISION

LAND CORNER RECORD

43 N 28 W
T. 43 NR. 27 W.

Dickinson COUNTY

DESCRIPTION OF CORNER Section Corner between Sections 25 and 36 on East
boundary of township. T 43 N R 27 W

DESCRIPTION OF CORNER MONUMENT 1" pipe with 4" brass cap.

WITNESSES TO CORNER 18" White Pine S 30° W 144 links

No other witnesses available

DESCRIPTION IN DETAIL AS TO HOW CORNER WAS LOCATED AND IDENTIFIED OR
RESTORED.

Replace Section Corner 25, 36, 30, 31.

Three White Pine stps. in proper place.

1" iron pipe and Cedar stake in ground.


This Section Corner shown to us by H. S. Peterson, District Forester.

Section Corner is on North edge of woods road.

New B.T. is.

Corner placed and witnessed August 16, 1955.

SURVEYORS SEAL

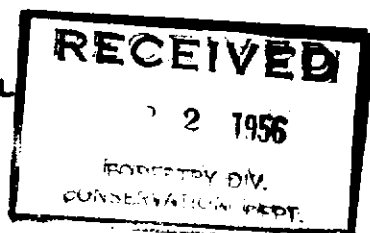

SIGNED

Billy D. Buckles
REGISTERED LAND SURVEYOR

DATE 2/27/56