

SURVEY & REMONUMENTATION

MAR 03 1998

LAND CORNER RECORDATION CERTIFICATE

Filing Requirement of Act 74, Mich. P.A. 1970

RECORDED

1997 OCT -9 AM 8:20

For corners in **SECTION**

Dickinson
(County)

Located In:

Corner Code #

Felch Twp.

- | | | | | | |
|--------------------------------------|---|------------|---|------------|------|
| 1. Public Land Survey | T | <u>43N</u> | R | <u>28W</u> | F-11 |
| | T | ___ | R | ___ | F-13 |
| | T | ___ | R | ___ | ___ |
| | T | ___ | R | ___ | ___ |
| 2. Property Controlling in Section | S | ___ | T | ___ | ___ |
| | S | ___ | T | ___ | ___ |
| 3. Miscellaneous Property in Section | S | ___ | T | ___ | ___ |
| | S | ___ | T | ___ | ___ |

REGISTER OF DEEDS
DICKINSON COUNTY
RON MOULTON, CLERK

Register of Deeds Stamp & File Number

4. Lot No. _____, Recorded Plat _____
5. Private Claims _____

	A	B	C	D	E	F	G	H	I	J	K	L	M
2	6	5	4	3	2	1							
3													
4	7	8	9	10	11	12							
5													
6	18	17	16	15	14	13							
7													
8	19	20	21	22	23	24							
9													
10	30	29	28	27	26	25							
11													
12	31	32	33	34	35	36							
13													

I, R.F. Perkins, in a field survey on July 27, 1997, do hereby certify that under requirements of P.A. 74, Michigan P.A. of 1970, the corner points mentioned in lines 1 and 2 above were in conformance with regulations and rules therefore as required in the current manual of survey instructions of the United States Department of the Interior, Bureau of Land Management or by a decree of a Court of Law and/or that the corner points mentioned in lines 3, 4 and 5 above were in conformance with the rules of the Michigan Board of Professional Surveyors or by a Decree of a Court of Law; established, re-established, monumented, re-monumented, recovered, found as expressed below:

NOTE: Not more than 4 corners, all in the same town and range, may be recorded on this certificate.

A. Description of original monument and accessories and/or subsequent restoration:

F-11 North 1/4 Corner, Section 33
Post by John Burt 1850
Original Bearing Trees
Y.Pine 20" S5°W 14 Lks.
Y.Pine 18" N35°E 43 Lks.

F-13 South 1/4 Corner, Section 33
Post by Wm. A. Burt 1846
Original Bearing Trees
Hemlock 18" N34°E 30 Lks.
Hemlock 17" N17°W 11 Lks.

B. Description of corner evidence found and/or method applied in restoring or reestablishing corner:

F-11 No evidence of Original Corner or Accessories Found.
Found 1 1/2" iron pipe set by Unknown Surveyor, buried in E of Dirt Road. Adjacent Metes and Bounds Parcels tied to this Corner. Corner accepted by Adjoining Property Owners as 1/4 Corner.

F-13 No evidence of Original Corner or Accessories Found.
Found 1 1/2" Iron Pipe projecting approx. 1 Foot out of Ground. Also 4 existing Witness Trees adjacent to Pipe.


ACCEPTED BY THE DICKINSON COUNTY SURVEY PEER GROUP AS THE OFFICIAL CORNER UNDER MICHIGAN PUBLIC ACT 345 OF 1990 AT A MEETING HELD ON
10-7-97
RFP
COUNTY REPRESENTATIVE

C. Description of monument for corner and accessories established to perpetuate locating the position of the corner:

F-11 Accepted Existing Iron Pipe as Best Available Evidence of 1/4 Corner Location.
Placed 2 1/2" Stamped D.C. Remon. Corner Inside of Existing Pipe.
New Witnesses
Red Pine 8" N83°E (M.B.) 54.72'
Red Pine 16" S25°E (M.B.) 23.57'
Red Pine 6" N32°W (M.B.) 31.16'
S.E. Corner Conc. Block Basement
S51°W (M.B.) 119.20'

F-13 Accepted above Found Pipe as Best Remaining Evidence of Corner Location.
New Bearing Trees
Oak 10" S23°E (M.B.) 4.13'
W.Pine 18" N55°E (M.B.) 42.82'
Oak 3" S56°W (M.B.) 25.04'
N12°W (M.B.) 15.34'

Signed by Robert F. Perkins
ROBERT F. PERKINS
Surveyor's Michigan License No. 12027

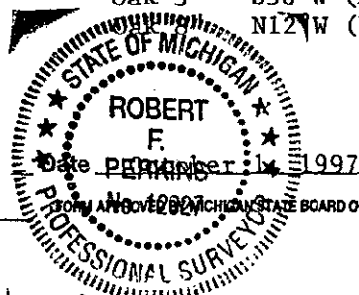

Book 2 - Page 298