

SURVEY & REMONUMENTATION

APR 27 1995

COMMISSION

LAND CORNER RECORDATION CERTIFICATE
Filing Requirement of Act 74, Mich. P.A. 1970

For corners in

Dickinson
(County)

Located In:

Corner Code #

- | | | |
|------------------------------------|---------------------------|-------|
| 1. Public Land Survey | T <u>43N</u> R <u>28W</u> | I-8 |
| | T <u>43N</u> R <u>28W</u> | K-8 |
| | T <u>43N</u> R <u>28W</u> | M-8 |
| | T _____ R _____ | _____ |
| 2. Property Controlling in Section | S _____ T _____ R _____ | _____ |
| | S _____ T _____ R _____ | _____ |
| 3. Miscellaneous Property in Sec. | S _____ T _____ R _____ | _____ |
| | S _____ T _____ R _____ | _____ |

REGISTERED
 DICKINSON COUNTY
 NOV 10 AM 9 41
 RECORDED

Register of Deeds Stamp & File Number

4. Lot No. _____, Recorded Plat _____
5. Private Claims _____

I, Ewart C. Muller, in a field survey on September, 19 94, do hereby certify that under requirements of P.A. 74, Michigan P.A. of 1970, the corner points mentioned in lines 1 and 2 above were in conformance with regulations and rules therefore as required in the current manual of survey instructions of the United States Department of the Interior, Bureau of Land Management or by a decree of a Court of Law and/or that the corner points mentioned in lines 3, 4 and 5 above were in conformance with the rules of the Michigan Board of Land Surveyors or by a Decree of a Court of Law; established, re-established, monumented, re-monumented, recovered, found as expressed below:

NOTE: Not more than 4 corners, all in the same town and range, may be recorded on this certificate. Township Subdivided by John Burt, DS, 1847

| A | B | C | D | E | F | G | H | I | J | K | L | M |
|----|----|----|----|----|----|----|---|---|---|---|---|---|
| 2 | 6 | 5 | 4 | 3 | 2 | 1 | | | | | | |
| 3 | | | | | | | | | | | | |
| 4 | 7 | 8 | 9 | 10 | 11 | 12 | | | | | | |
| 5 | | | | | | | | | | | | |
| 6 | 18 | 17 | 16 | 15 | 14 | 13 | | | | | | |
| 7 | | | | | | | | | | | | |
| 8 | 19 | 20 | 21 | 22 | 23 | 24 | | | | | | |
| 9 | | | | | | | | | | | | |
| 10 | 30 | 29 | 28 | 27 | 26 | 25 | | | | | | |
| 11 | | | | | | | | | | | | |
| 12 | 31 | 32 | 33 | 34 | 35 | 36 | | | | | | |
| 13 | | | | | | | | | | | | |

A. Description of original monument and accessories and/or subsequent restoration:

- I-8 Set cedar Qr. Section Post(Between Sections 22 & 23) (E.R. Nelson found post 1931 Road Survey)
BT's: Cedar 10 S72E 30 lks; Cedar 14 N75W 31 lks. (BT's destroyed during road construction)
- K-8 Set sugar Qr. Section Post(Between Sections 23 & 24) (E.R. Nelson found post 1931 Road Survey)
BT's: Sugar 16 S52E 21 lks; Sugar 18 N75W 48 lks. (Destroyed during road construction)
- M-8 Set cedar Qr. Section Post between Section 24-43-28 & Section 19-43-27 (E.R. Nelson found post 1931 Road Survey)
BT's: Sugar 8 N52½E 25 lks; Sugar 8 S48W 7 lks. (Destroyed during road construction)

B. Description of corner evidence found and/or method applied in restoring or reestablishing corner:

- I-8 E.R. Nelson drove 3/4-inch round iron during 1931 Road Survey. (Found round iron)
- K-8 E.R. Nelson drove round iron during 1931 Road Survey. (Found RR spike over round iron)
- M-8 E.R. Nelson drove round iron during 1931 Road Survey. (Found RR spike over round iron)


ACCEPTED BY THE DICKINSON COUNTY SURVEY PEER GROUP AS THE OFFICIAL CORNER UNDER MICHIGAN PUBLIC ACT 345 OF 1990 AT A MEETING HELD ON 11-7-94
ICJP
COUNTY REPRESENTATIVE

C. Description of monument for corner and accessories established to perpetuate locating the position of the corner:

- I-8 Set Dickinson County Cap/rod in Monument Box. NBT's: PP# 86-24618 N25W 41.00; W. Spruce 13 S61E 55.15; NBT's: PP# 94-03529 S32W 27.90; 1½ x 48-inch I.D. iron pipe North 33.14.
- K-8 Set Dickinson County Cap/rod in Monument Box. NBT's: H. Mpl 11 N15W 59.00; PP# 80-23001 N 05 E 36.91; NBT's: H. Mpl 15 S16W 53.35; H. Mpl 9 S26E 68.84.
- M-8 Set Dickinson County Cap/rod in Monument Box. NBT's: PP# 86-25348 N48W 52.17; Aspen 9 S30E 46.52; NBT's: Fillis Road Sign iron pipe N36E 41.70; PP# 93-22448 S50W 46.80.

Note: Bearings are Magnetic. Distances measured to center of pipes and 16d nails in side of trees

Signed by Ewart C Muller Date November 7, 1994
Surveyor's Michigan License No. 15408

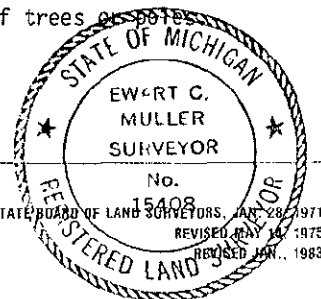

Liben 2 page 107