

MICHIGAN
DEPARTMENT OF CONSERVATION
FORESTRY DIVISION

LAND CORNER RECORD

T. 43 N.R. 28 W


Dickinson COUNTY

DESCRIPTION OF CORNER East 1/8 between 20-29

CORNER MONUMENT 1" Iron Pipe with 4" Aluminum Cap

DATE MONUMENT PLACED AND WITNESSED 12-29-62

WITNESSES TO CORNER..... BT's: 20" W. Pine Stub (BT) N 86° W 35 links

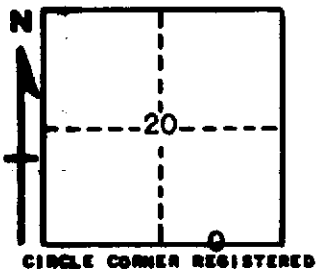

8" Aspen (BT) N 21° E 31½ links

AND

DESCRIPTION IN DETAIL AS TO HOW CORNER WAS LOCATED AND IDENTIFIED OR RESTORED.

This corner placed midway and on line between Section Corner to East and 1/4 Corner to West.

SURVEYOR'S SEAL

SIGNED Billy D. Buckler DATE 8-22-63
REGISTERED LAND SURVEYOR
Billy D. Buckler