

**LAND CORNER RECORDATION CERTIFICATE**  
**Filing Requirement of Act 74, Mich. P.A. 1970**

For corners in  
Dickinson  
 (County)

Located In: Corner Code #

- |                                    |                           |       |
|------------------------------------|---------------------------|-------|
| 1. Public Land Survey              | T <u>43N</u> R <u>28W</u> | J9    |
|                                    | T <u>43N</u> R <u>28W</u> | I10   |
|                                    | T _____ R _____           | _____ |
|                                    | T _____ R _____           | _____ |
| 2. Property Controlling in Section | S _____ T _____ R _____   | _____ |
|                                    | S _____ T _____ R _____   | _____ |
| 3. Miscellaneous Property in Sec.  | S _____ T _____ R _____   | _____ |
|                                    | S _____ T _____ R _____   | _____ |

Register of Deeds Stamp & File Number

4. Lot No. \_\_\_\_\_, Recorded Plat \_\_\_\_\_  
 5. Private Claims \_\_\_\_\_

May 17 2001

I, Stephan J. Szyszkoski, in a field survey on \_\_\_\_\_, 19\_\_\_\_ do hereby state that under requirements of P.A. 74, Michigan P.A. of 1970, the corner points mentioned in lines 1 and 2 above were in conformance with regulations and rules therefore as required in the current manual of survey instructions of the United States Department of the Interior, Bureau of Land Management or by a decree of a Court of Law and /or that the corner points mentioned in lines 3, 4 and 5 above were in conformance with the rules of the Michigan Board of Land Surveyors or by a Decree of a Court of Law; established, re-established, monumented, recovered, found as expressed below:

**NOTE:** Not more than 2 corners, all in the same town and range, may be recorded on this certificate.

	A	B	C	D	E	F	G	H	I	J	K	L	M
1													
2	6		5		4		3		2		1		
3													
4	7		8		9		10		11		12		
5													
6	18		17		16		15		14		13		
7													
8	19		20		21		22		23		24		
9									●				
10	30		29		28		27		●	26		25	
11													
12	31		32		33		34		35		36		
13													

**A. Description of original monument and accessories and/or subsequent restoration:**

(J9) Quarter corner common to Sections 23-26. Corner established in 1850 by John Burt: ...39.90 Set Cedar Quarter Section post. Sugar 14 S22E 18, Hemlock 16 N70W 25.

(I10) Quarter corner common to Sections 26-27. Established in 1850 by John Burt. "...40.02 Y. Birch quarter Section post. W.Pine 30 N23W 26, do 24 S36E 51." Notes by H.S.Peterson RLS, dated 4/20/53, at the Michigan Dept. of Natural Resources office in Felch, MI, show "WP" [wood post] and "IP" [iron pipe] at this corner.


**B. Description of corner evidence found and/or method applied in restoring or reestablishing corner:**

(J9) The original post and accessories were not recovered. Found no acceptable evidence of the position of the original corner on the ground. Reestablished the corner midway and on a line of mean true bearing between monumented section corners 2633.70' east and west.  
 (I10) The original post and accessories were not recovered. Found a 1.5" ID iron pipe set firmly, S72E, 11 feet from the single proportionate position. Accepted same as the best available evidence of the position of the original corner.

**C. Description of monument for corner and accessories established to perpetuate locating the position of the corner:**

(J9) Set 1" IDx32" iron pipe with 4 alum. MDNR cap. Blazed and scribed:  
 10" R. Pine N46E 30.0' "1/4S NBT"  
 8" J. Pine S75W 23.7' do  
 8" Spruce N44W 36.1' do  
 10" R. Pine N11E 42.8' do  
 Placed sq'd cedar post adjacent.  
 Bearings are magnetic. Distances to notch in lower blaze.

(I10) Drove 1" IDx32" iron pipe with 4 alum. MDNR cap into found 1.5" ID IP. Blazed and scribed:  
 6" W.Spruce N52E 31.8' "1/4S NBT"  
 10" R.Pine S40E 77.3' do  
 5" W.Pine S70W 12.5' do  
 12" R.Pine N29W 34.5' do  
 Placed sq'd cedar post adjacent.  
 Bearings are magnetic. Distances are to notch in lower blaze.

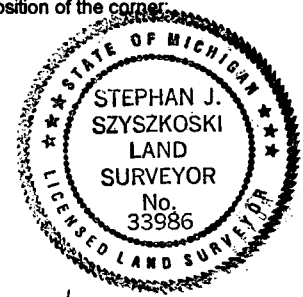

Signed by Stephan J. Szyszkoski Date 7/18/01  
 Surveyor's Michigan License No. 33986

For the Michigan Department of Natural Resources - Forest Management Division