

MAY 07 1997

COMMISSION

LAND CORNER RECORDATION CERTIFICATE
Filing Requirement of Act 74, Mich. P.A. 1970

RECORDED

1996 SEP 11 PM 2:29

For corners in

Dickinson
(County)

Located In:

Corner Code #

- 1. Public Land Survey T 43N R 30W ✓ C-2
- T _____ R _____
- T _____ R _____
- T _____ R _____
- 2. Property Controlling S _____ T _____ R _____
- in Section S _____ T _____ R _____
- 3. Miscellaneous S _____ T _____ R _____
- Property in Section S _____ T _____ R _____

REGISTER OF DEEDS
DICKINSON COUNTY
RON ROBERTSON (M 4980)

Register of Deeds Stamp & File Number

- 4. Lot No. _____, Recorded Plat _____
- 5. Private Claims _____

A	B	C	D	E	F	G	H	I	J	K	L	M
2	6	5	4	3	2	1						
3												
4	7	8	9	10	11	12						
5												
6	18	17	16	15	14	13						
7												
8	19	20	21	22	23	24						
9												
10	30	29	28	27	26	25						
11												
12	31	32	33	34	35	36						
13												

I, James H. Moore, in a field survey on May 30, 1996, do hereby certify that under requirements of P.A. 74, Michigan P.A. of 1970, the corner points mentioned in lines 1 and 2 above were in conformance with regulations and rules therefore as required in the current manual of survey instructions of the United States Department of the Interior, Bureau of Land Management or by a decree of a Court of Law and/or that the corner points mentioned in lines 3, 4 and 5 above were in conformance with the rules of the Michigan Board of Professional Surveyors or by a Decree of a Court of Law; established, re-established, monumented, re-monumented, recovered, found as expressed below:

NOTE: Not more than 4 corners, all in the same town and range, may be recorded on this certificate.

A. Description of original monument and accessories and/or subsequent restoration:

C-2 West 1/4 Corner Section 5
Spruce Post - Harvey Mellen 1848
Original Bearing Trees
Spruce 3" N38E 44 LKS
Tamarack 5" N75 1/2 W 146 LKS

B. Description of corner evidence found and/or method applied in restoring or reestablishing corner:


C-2 No Evidence of Original Corner or Accessories remains
Found 1" O.D. Pipe projecting about 7"

ACCEPTED BY THE DICKINSON COUNTY SURVEY PEER GROUP AS THE OFFICIAL CORNER UNDER MICHIGAN PUBLIC ACT 345 OF 1990 AT A MEETING HELD ON
9-9-96
RFP
COUNTY REPRESENTATIVE

C. Description of monument for corner and accessories established to perpetuate locating the position of the corner:

C-2 Accepted above described corner
Replaced 1" pipe with 2 1/2" Stamped D.C. Remon. Corner
New Witnesses
Tamarack 9" N28W 14.45'
Tamarack 5" S65W 28.88'
Tamarack 3" S50E 22.54'
Tamarack 4" N32E 20.27'
Carsonite Stake South 2'

Signed by

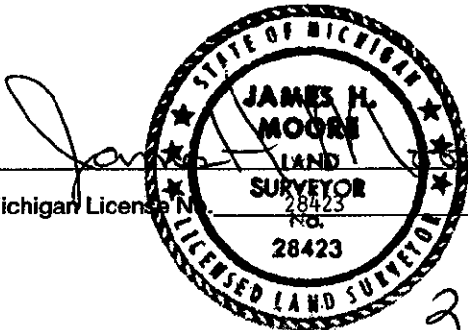

Date July 2, 1996

Surveyor's Michigan License No. _____

206