

SURVEY & REMONUMENTATION

NOV 15 1999

RECORDED

1994 NOV -8 AM 9:28

SECTION

LAND CORNER RECORDATION CERTIFICATE
Filing Requirement of Act 74, Mich. P.A. 1970

For corners in

Dickinson
(County)

Located In:

Corner Code #

- 1. Public Land Survey T 43N R 30W E-3 & F-3
- T _____ R _____
- T _____ R _____
- T _____ R _____
- 2. Property Controlling S _____ T _____ R _____
- in Section S _____ T _____ R _____
- 3. Miscellaneous S _____ T _____ R _____
- Property in Sec. S _____ T _____ R _____

REGISTER OF DEEDS
DICKINSON COUNTY
RON MOULTON, CLERK

Register of Deeds Stamp & File Number

- 4. Lot No. _____, Recorded Plat _____
- 5. Private Claims _____

| | A | B | C | D | E | F | G | H | I | J | K | L | M |
|----|----|----|----|----|----|----|---|---|---|---|---|---|---|
| 2 | 6 | 5 | 4 | 3 | 2 | 1 | | | | | | | |
| 3 | | | | | | | | | | | | | |
| 4 | 7 | 8 | 9 | 10 | 11 | 12 | | | | | | | |
| 5 | | | | | | | | | | | | | |
| 6 | 18 | 17 | 16 | 15 | 14 | 13 | | | | | | | |
| 7 | | | | | | | | | | | | | |
| 8 | 19 | 20 | 21 | 22 | 23 | 24 | | | | | | | |
| 9 | | | | | | | | | | | | | |
| 10 | 30 | 29 | 28 | 27 | 26 | 25 | | | | | | | |
| 11 | | | | | | | | | | | | | |
| 12 | 31 | 32 | 33 | 34 | 35 | 36 | | | | | | | |
| 13 | | | | | | | | | | | | | |

I, Edward Kazianka, in a field survey on October 18, 19 94, do hereby certify that under requirements of P.A. 74, Michigan P.A. of 1970, the corner points mentioned in lines 1 and 2 above were in conformance with regulations and rules therefore as required in the current manual of survey instructions of the United States Department of the Interior, Bureau of Land Management or by a decree of a Court of Law and/or that the corner points mentioned in lines 3, 4 and 5 above were in conformance with the rules of the Michigan Board of Land Surveyors or by a Decree of a Court of Law; established, re-established, monumented, re-monumented, recovered, found as expressed below:

NOTE: Not more than 4 corners, all in the same town and range, may be recorded on this certificate.

A. Description of original monument and accessories and/or subsequent restoration:

E-3 Wood Post. Hemlock 8 N22E 31 lks. Cedar 12 S28W 07 lks.

1" by 3" Iron bar set by persons unknown.

October 3, 1988 E. Kazianka recorded iron bar as the Section Corner in Liber 1, Page 421 of Dickinson County Land Corner recordation certificates.

F-3 Wood Post. Cedar 10 N35W 18 lks. Y. Birch 6 S12E 17 lks.

B. Description of corner evidence found and/or method applied in restoring or reestablishing corner:

E-3 Found 1" by 3" Iron bar six inches below gravel road surface. Two railroad signs used as witnesses have been moved. P. Pole S29E 63.70 feet in place.

F-3 No evidence of original corner or accessories found. Thus set Quarter Corner by proportionate measurement. Section Corners 1/2 mile to the east and west are set with a distance of 5295.50 feet between them. Set the Quarter Corner at the mid-point and on line between the two section corners.

ACCEPTED BY THE DICKINSON COUNTY SURVEY PEER GROUP AS THE OFFICIAL CORNER UNDER MICHIGAN PUBLIC ACT 345 OF 1990 AT A MEETING HELD ON


11-7-94

COUNTY REPRESENTATIVE

C. Description of monument for corner and accessories established to perpetuate locating the position of the corner:

E-3 Set a 1" by 18" threaded iron rod with a 1 1/2" nut on it's top in place of the iron bar as the Section Corner. Iron rod is six inches below the road surface. Railroad Sign N39E 25.35 feet. P. Pole S 29E 63.70 feet. Center of the south rail of the railroad track N 04E 31.92 feet. A Dickinson County Survey cap stamped "W.C. 5/4 33' West! East 33.00 feet. 8/9

F-3 2 1/2 inch Dickinson County Survey cap on a three foot Aluminum rod. Cedar 18 N24W 28.85 feet. Cedar 6 N44E 19.17 feet. Cedar 8 S69E 30.98 feet. Spruce 9 S18E 25.97 feet.

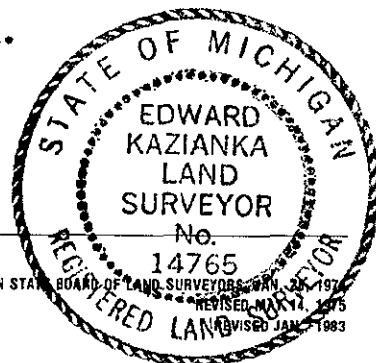

Signed by Edward Kazianka
Surveyor's Michigan License No. 14765

Date October 24, 1994

FORM APPROVED BY MICHIGAN STATE BOARD OF LAND SURVEYORS JAN 24 1970 REVISED MAY 17 1975 REVISED JAN 1983

Liber 2 Page 104