

SURVEY & REMONUMENTATION

APR 27 1995

COMMISSION

LAND CORNER RECORDATION CERTIFICATE Filing Requirement of Act 74, Mich. P.A. 1970

For corners in

Dickinson <small>(County)</small>	Located In:	Corner Code: <u>G-3 & G-7</u>
1. Public Land Survey	T <u>43N</u> R <u>30W</u>	
	T _____ R _____	
	T _____ R _____	
	T _____ R _____	
2. Property Controlling in Section	S _____ T _____ R _____	
	S _____ T _____ R _____	
3. Miscellaneous Property in Sec.	S _____ T _____ R _____	
	S _____ T _____ R _____	
4. Lot No. _____, Recorded Plat _____		
5. Private Claims _____		

RECORDED
1991 SEP - 8 AM 8: 51
REGISTER OF DEEDS
DICKINSON COUNTY
MICHIGAN

Register of Deeds Stamp & File Number

I, Edward Kazianka, in a field survey on September 2, 1994, do hereby certify that under requirements of P.A. 74, Michigan P.A. of 1970, the corner points mentioned in lines 1 and 2 above were in conformance with regulations and rules therefore as required in the current manual of survey instructions of the United States Department of the Interior, Bureau of Land Management or by a decree of a Court of Law and/or that the corner points mentioned in lines 3, 4 and 5 above were in conformance with the rules of the Michigan Board of Land Surveyors or by a Decree of a Court of Law; established, re-established, monumented, re-monumented, recovered, found as expressed below:

NOTE: Not more than 4 corners, all in the same town and range, may be recorded on this certificate.

	A	B	C	D	E	F	G	H	I	J	K	L	M
2	6	5	4	3	2	1							
3							•						
4	7	8	9	10	11	12							
5													
6	18	17	16	15	14	13							
7							•						
8	19	20	21	22	23	24							
9													
10	30	29	28	27	26	25							
11													
12	31	32	33	34	35	36							
13													

A. Description of original monument and accessories and/or subsequent restoration:

- G-3 Wood Post Cedar 16 N53E 16 lks. Cedar 10 S28W 07 lks.
1/4 inch Alum. cap on a 1 inch pipe set by Sperhake, RLS 7876 on 7-22-65.
Tamarack 8 N54E 45 1/2 lks. Tamarack 5 S69W 31 1/2 lks.
Cedar 6 N67W 15 1/2 lks. Cedar 10 S57W 49 1/2 lks.
- G-7 Wood Post W. Pine 36 S28E 16 lks. Lynn 8 N14W 10 lks.
3/4 inch Iron pin set in south edge of road by persons unknown.
Pine stump in place of original B.T.
Cedar scribed " S 15 N.B.T."

B. Description of corner evidence found and/or method applied in restoring or reestablishing corner:


- G-3 Pipe and cap set by Sperhake. Four bearing trees are still living.
- G-7 3/4 inch Iron pin. Accepted pin as marking the site of the original corner.

ACCEPTED BY THE DICKINSON COUNTY SURVEY PEER GROUP AS THE OFFICIAL CORNER UNDER MICHIGAN PUBLIC ACT 345 OF 1990 AT A MEETING HELD ON
9-7-94
ROAP
COUNTY REPRESENTATIVE

C. Description of monument for corner and accessories established to perpetuate locating the position of the corner:

- G-3 1/4 inch Alum. cap on a 1 inch iron pipe.
Tamarack 13 N58E 30.55 feet. Tamarack 10 S70W 20.65 feet.
Cedar 9 N66W 10.12 feet. Cedar 12 S53E 32.90 feet.
- G-7 3/4 inch Iron pin, 4 inches below surface, in south edge of road.
Cedar 18 N77E 27.15 feet scribed "S 15 N.B.T." Maple 9 S46W 5.75 feet.
Maple 6 N36W 43.15 feet. Maple 4 S86E 33.40 feet.
Large Pine stump S26E 11 feet
A Dickinson County Survey cap stamped "W.C. $\frac{16}{21} \frac{15}{22}$ 33' SOUTH". North $\frac{16}{21} \frac{15}{22}$ 33.00 feet

Signed by Edward Kazianka Date September 6, 1994
Surveyor's Michigan License No. 14765

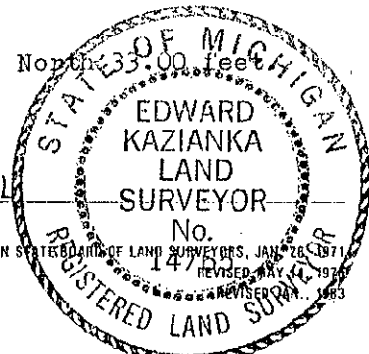

Liber 2 Page 100