SURVEY &
REMONUMENTATION

APR 27 1995

COMMISSION

LAND CORNER RECORDATION CERTIFICATE

Filing Requirement of Act 74, Mich. P.A. 1970

For corners in

Dickinson (County) Located In: Corner Code 11

1. Public Land Survey	T 43N R 30W	H-5 & I-5
	T ____ R ____	
	T ____ R ____	
	T ____ R ____	
2. Property Controlling	S ____ T ____ R ____	
in Section	S ____ T ____ R ____	
3. Miscellaneous	S ____ T ____ R ____	
Property in Sec.	S ____ T ____ R ____	

RECORDED
1994 SEP -8 AM 8 52
REGISTER OF DEEDS
DICKINSON COUNTY, MI

Register of Deeds Stamp & File Number

4. Lot No. _____ , Recorded Plat _____
5. Private Claims _____

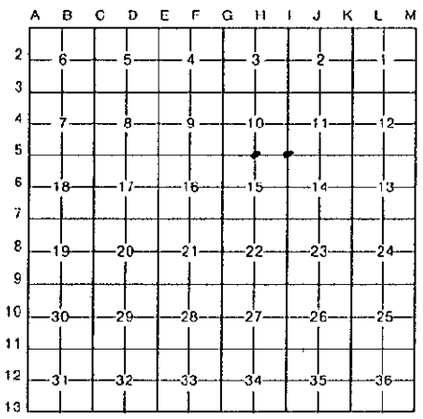

I, Edward Kazianka, in a field survey on Sept. 2, 1994, do hereby certify that under requirements of P.A. 74, Michigan P.A. of 1970, the corner points mentioned in lines 1 and 2 above were in conformance with regulations and rules therefore as required in the current manual of survey instructions of the United States Department of the Interior, Bureau of Land Management or by a decree of a Court of Law and/or that the corner points mentioned in lines 3, 4 and 5 above were in conformance with the rules of the Michigan Board of Land Surveyors or by a Decree of a Court of Law; established, re-established, monumented, re-monumented, recovered, found as expressed below:

NOTE: Not more than 4 corners, all in the same town and range, may be recorded on this certificate.

A. Description of original monument and accessories and/or subsequent restoration:

H-5 Wood Post Cedar 10 S31E 10 lks. Cedar 12 N38E 35 lks.

I-5 Wood Post Cedar 12 S28E 09 lks. Cedar 14 N21W 33 lks.

ACCEPTED BY THE DICKINSON COUNTY SURVEY PEER GROUP AS THE OFFICIAL CORNER UNDER MICHIGAN PUBLIC ACT 345 OF 1990 AT A MEETING HELD ON 9-7-94

ECAP
COUNTY REPRESENTATIVE

B. Description of corner evidence found and/or method applied in restoring or reestablishing corner:

H-5 No evidence of original corner or accessories found. Set the Quarter Corner by proportionate measurment at the mid-point and on line between the section corners ½ mile to the east and west.

I-5 No evidence of original corner or accessories found. Thus, set corner by proportionate measurment. For north-south position: The distance from the south edge of the Ford River between Sections 14 and 15 to the corner of Sections 2, 3, 10 and 11 is 5773.07 feet. Proportionately then the corner should be set 5308.57 feet South of the corner common to Sections 2,3, 10 and 11. For east-west position: The section corner 1 mile east and the section corner 2 miles west are in with a distance of 15,890.88 feet between them. Proportionately then the corner should be set 5307.99 feet West of the corner common to Sections 11, 12, 13 amd 14. Thus set the section corner at the above noted position. The Ford River is 464.5 feet south of this corner.

C. Description of monument for corner and accessories established to perpetuate locating the position of the corner:

H-5 2½ inch Dickinson County Survey cap on a three foot Aluminum rod.
Cedar 10 N63E 18.53 feet. Cedar 12 N89W 4.35 feet. Cedar 7 S60W 10.48 feet.
Cedar 5 S34E 13.70 feet.

I-5 2½ inch Dickinson County Survey cap on a three foot Aluminum rod.
Cedar 8 N05W 30.07 feet. Cedar 6 N65E 28.63 feet. Cedar 6 S59E 34.75 feet.
Cedar 9 S10½W 4.00 feet.

STATE OF MICHIGAN
EDWARD KAZIANKA
LAND SURVEYOR
No. 14765
REGISTERED LAND SURVEYOR

Signed by Edward Kazianka Date September 6, 1994

Surveyor's Michigan License No. 14765

FORM APPROVED BY MICHIGAN STATE BOARD OF LAND SURVEYORS, JAN. 20, 1971
REVISED MAY 14, 1975
REVISED JAN. 1, 1983

Liber 2 Page 102